

LAND CORNER RECORDATION CERTIFICATE
Filing Requirement of Act 74, Mich. P.A. 1970

#1230

For corners in

<u>Missaukee</u> (County)	Located In:	Corner Code #
1. Public Land Survey	T 23N R 6W	M-12
	T R	
	T R	
	T R	
2. Property Controlling in Section	S T R	
	S T R	
3. Miscellaneous Property in Sec.	S T R	
	S T R	
4. Lot No. _____, Recorded Plat _____		
5. Private Claims _____		

LIBER 315 PAGE 1123
 MISSAUKEE COUNTY MICHIGAN
 RECORDED DEC 29 1997 ^{1:35} P.M.
Paula F. Clark
 Register of Deeds Stamp
 Number

I, Daniel E. Schripsema, in a field survey on October 1, 19 97 do hereby state that under requirements of P.A. 74, Michigan P.A. of 1970, the corner points mentioned in lines 1 and 2 above were in conformance with regulations and rules therefore as required in the current manual of survey instructions of the United States Department of the Interior, Bureau of Land Management or by a decree of a Court of Law and /or that the corner points mentioned in lines 3, 4 and 5 above were in conformance with the rules of the Michigan Board of Land Surveyors or by a Decree of a Court of Law; established, re-established, monumented, recovered, found as expressed below:

A	B	C	D	E	F	G	H	I	J	K	L	M
1												
2	6		5		4		3		2		1	
3												
4	7		8		9		10		11		12	
5												
6	10		17		16		15		14		13	
7												
8	19		20		21		22		23		24	
9												
10	30		29		28		27		26		25	
11												
12	31		32		33		34		35		36	
13												


NOTE: Not more than 2 corners, all in the same town and range, may be recorded on this certificate

- A. Description of original monument and accessories and/or subsequent restoration:
 M-12) 1839 GLO survey set quarter post section 36; Spruce 8 S28 1/2W 15, Cedar 8 N64 1/2W 8 1854 A. Curtis, DS, corner mentioned but no witnesses or comment
- B. Description of corner evidence found and/or method applied in restoring or reestablishing corner:
 M-12) Quarter corner common to Section 36, T23N, R6W and Section 31, T23N, R5W. Set 1/2rebar with Missaukee County Monument by single proportionate distance to GLO measurement of 1854 and on line with Section corners to North and South.
 This corner is accepted as a careful and faithful reestablishment of the position of the original corner.
- C. Description of monument for corner and accessories established to perpetuate locating the position of the corner:
 M-12) Set Missaukee County Monument on 1/2rebar
 N45E 8.97' 8" cedar
 S85E 22.51' 14" cedar
 S10W 14.10' 12" cedar
 S80W 12.57' 4" balsam
 North 20' centerline trail

Peer Group Reviewed and Approved
 Date: 12-8-97
 J. Dgan Geers, Missaukee Co. Representative

Signed by Daniel E. Schripsema Date 12-2-97

Surveyor's Michigan License No. 24617

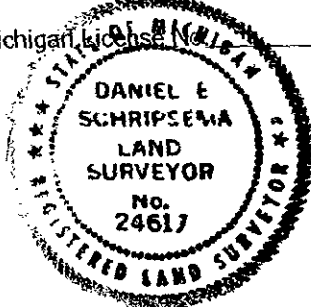

SURVEY & REMONUMENTATION

JAN 16 1998

SECTION