

MICHIGAN
DEPARTMENT OF CONSERVATION
FORESTRY DIVISION

LAND CORNER RECORD

T. 23 N.R. 7 W.


Missaukee COUNTY

DESCRIPTION OF CORNER Section corner common to Sections 8 - 9 - 16 - 17

CORNER MONUMENT Left 1" iron bolt with 1½" sq. head in place

DATE MONUMENT PLACED AND WITNESSED April 24, 1962

WITNESSES TO CORNER.....

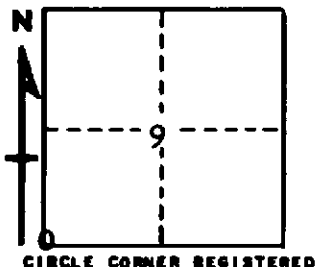

12" Twin Maple N 16 E - 56.5'

16" R. Oak S 68½ W - 123.8'

AND
Cor. Fence Post North - 21.5'

DESCRIPTION IN DETAIL AS TO HOW CORNER WAS LOCATED AND IDENTIFIED OR RESTORED.

This corner was found while making a survey in Section 9. Found a 1" bolt, surrounded by rocks at corner, below surface of N. wheel track, as established by County Surveyor in 1909 survey of this area. Stump of 4" cherry NBT in place, and a site for SW W. Pine stump NBT in line with fence north. A 1914 survey by Beauthien perpetuated this corner and noted the OBTs still in place.

SURVEYOR'S SEAL

SIGNED *Kenneth J. Oetting* DATE April 27, 1962
REGISTERED LAND SURVEYOR