LAND CORNER RECORDATION CERTIFICATE

Filing Requirement of Act 74, Mich. P.A. 1970

For corners in MISSAUKEE (County)

	Located In:	Corner Code ##
1. Public Land Survey	T 23N R 7W	I-7,I-8,J-9
	T R	
	T R	
	T R	
2. Property Controlling	S 23 T R	3
in Section	S T R	
3. Miscellaneous	S T R	
Property in Sec.	S T R	

Register of Deeds Stamp & File Number

4. Lot No. _____ , Recorded Plat _____
5. Private Claims _____

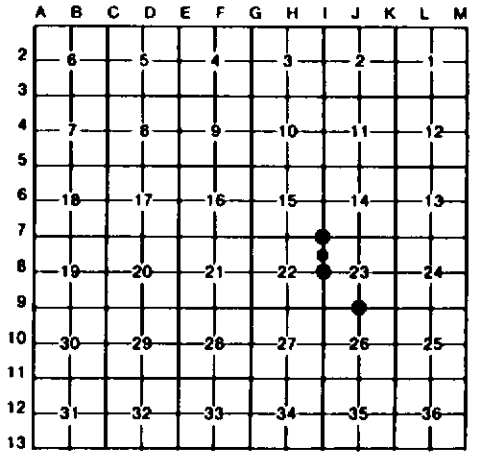

I, CARL KIISKILA , in a field survey on MAY 5 , 19 95 , do hereby certify that under requirements of P.A. 74, Michigan P.A. of 1970, the corner points mentioned in lines 1 and 2 above were in conformance with regulations and rules therefore as required in the current manual of survey instructions of the United States Department of the Interior, Bureau of Land Management or by a decree of a Court of Law and/or that the corner points mentioned in lines 3, 4 and 5 above were in conformance with the rules of the Michigan Board of Land Surveyors or by a Decree of a Court of Law; established, re-established, monumented, re-monumented, recovered, found as expressed below:

NOTE: Not more than 4 corners, all in the same town and range, may be recorded on this certificate.

A. Description of original monument and accessories and/or subsequent restoration:

I-7 I-8 J-9 3

(NO EVIDENCE OF G.L.O. CORNER, B.T'S, LINE TREES & TOPOGRAPHY, AS CALLED OUT IN THE G.L.O. LINE NOTES; UNLESS NOTED IN ITEM "B" BELOW.)

STATE OF MICHIGAN
CARL KIISKILA
LAND SURVEYOR
No. 33981
LICENSED LAND SURVEYOR

B. Description of corner evidence found and/or method applied in restoring or reestablishing corner:

I-7
FOUND AND ACCEPTED 1/2" IRON PREVIOUSLY WITNESSED BY J. WILCOX. REPLACED WITH A 1" X 72" GALV PIPE W/ALUM DNR CAP. (WILCOX SET IRON IN 1981 ON BASIS OF SURVEY FOR MISS CO RD COMM IN 1910). CTR OLD N-S ABANDONED CORDUROY RD BED IS 36'± E.

I-8
REESTABLISHED THE W 1/4 COR OF SEC 23; MIDWAY AND ON LINE BETWEEN REESTABLISHED SW AND FD NW CORNERS OF SEC 23. COR FITS US TIE TO SLY EDGE OF SWAMP NORTH; US MEAS 825', WE MEAS 832'±. CTR WINDING N-S SAND RD EAST 16'±. POST ROW EASTERLY EXTENDS EAST AND IS 3' N OF CORNER.

J-9
REESTABLISHED S 1/4 COR OF SEC 23 EQUIDISTANCE FROM FD SE S-23 & REESTABLISHED SW S-23 & ON AVERAGE CTR LINE OF ROAD TO EAST (WITH ROW FENCE, 25'± SLY OF RD TO EAST).

3
ESTABLISHED THE SW COR OF THE NW 1/4 OF THE NW 1/4 OF SEC 23, PER STANDARD BLM INSRUCTIONS. CORNER FALLS IN SWAMP, 170' NORTH OF SOUTH EDGE.

FD A 1/2"x 16" REROD IN CTR OF TRAIL, 15.13' EASTERLY OF SET REF. MON.

C. Description of monument for corner and accessories established to perpetuate locating the position of the corner:

I-7
REPLACED FD 1/2" X 18" SMOOTH IRON ROD W/ 1" X 72" GALV PIPE W/ALUM DNR CAP.

#7" CEDAR	NORTH	4.07'
#7" CEDAR	N55°E	15.70'
#6" CEDAR	S80°E	10.60'
#8" CEDAR	S20°E	11.42'

I-8
SET 1" X 36" IRON PIPE W/ALUM DNR CAP & CARSONITE POST.

20" R. PINE	N45°E	54.46'
4" W. PINE	S85°E	40.89'
8" R. PINE	S30°E	73.42'
5" W. PINE	N60°W	16.73'

J-9
SET 5/8" X 32" REROD W/CAP IN E-W ROAD.
SET CARSONITE POST NORTH 33.0'

22" R. PINE	N61°E	35.12'
13" TWN R.PINE	S09°W	79.21'
3" TRI B.CHERRY	N19°W	17.14'
NW CORNER WOOD FRAME CABIN	S15°E	124.9'

3
SET 1"x 72" PIPE W/PS CAP & CARSONITE POST - NO WIT.
AVAILABEL - SET REFERENCE MON, A 1"x 60" PIPE W/ALUMN DNR CAP, S00°34'29"E, 170.85'
-- REF. MON. WIT'S --

3"SPRUCE	N04°E	21.38'
2"BALSAM	S83°E	4.69'
5"MAPLE	S04°W	24.48'
6"SPRUCE	S85°W	23.89'

= PS J.WILCOX WIT.

Signed by Carl T. Kiiskila Date 3-28-97

Surveyor's Michigan License No. 33981

FORM APPROVED BY MICHIGAN STATE BOARD OF LAND SURVEYORS, JAN. 28, 1971
REVISED MAY 14, 1975
REVISED JAN., 1983