LAND CORNER RECORDATION CERTIFICATE

Filing Requirement of Act 74, Mich. P.A. 1970

For corners in
MISSAUKEE
(County)

	Located In:	Corner Code ##
1. Public Land Survey	T 23N R 7W	G-9,H-9,I-9
	T ___ R ___	
	T ___ R ___	
	T ___ R ___	
2. Property Controlling	S 23 T ___ R ___	15
in Section	S ___ T ___ R ___	
3. Miscellaneous	S ___ T ___ R ___	
Property in Sec.	S ___ T ___ R ___	

Register of Deeds Stamp & File Number

4. Lot No. _____ , Recorded Plat _____
5. Private Claims _____

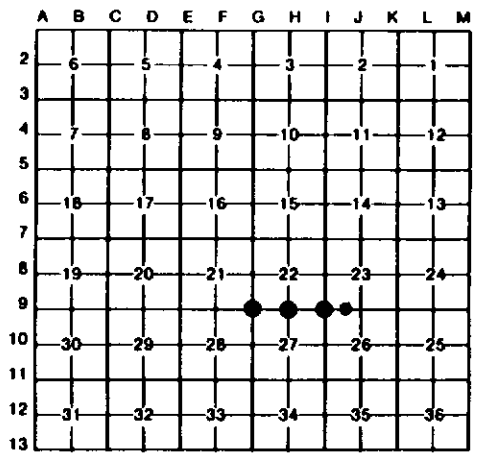

I, CARL KIISKILA , in a field survey on MAY 5 , 19 95 , do hereby certify that under requirements of P.A. 74, Michigan P.A. of 1970, the corner points mentioned in lines 1 and 2 above were in conformance with regulations and rules therefore as required in the current manual of survey instructions of the United States Department of the Interior, Bureau of Land Management or by a decree of a Court of Law and/or that the corner points mentioned in lines 3, 4 and 5 above were in conformance with the rules of the Michigan Board of Land Surveyors or by a Decree of a Court of Law; established, re-established, monumented, re-monumented, recovered, found as expressed below:

NOTE: Not more than 4 corners, all in the same town and range, may be recorded on this certificate.

15 STATE OF MICHIGAN CARL KIISKILA LAND SURVEYOR No. 33981 LICENSED LAND SURVEYOR

A. Description of original monument and accessories and/or subsequent restoration:

G-9 H-9 I-9

(NO EVIDENCE OF G.L.O. CORNER, B.T'S, LINE TREES & TOPOGRAPHY, AS CALLED OUT IN THE G.L.O. LINE NOTES; UNLESS NOTED IN ITEM "B" BELOW.)

B. Description of corner evidence found and/or method applied in restoring or reestablishing corner:

G-9
FOUND AND ACCEPTED 1/2" IRON PIN AS SET BY C. HUGHES P.S. AT FOUND LARGE STONE, IN 1978 SURVEY FOR NW 1/4 SEC 27. PIN IS 8" BELOW GRADE LOCATED ON E EDGE RD TO S AND CTR RD TO E.

H-9
REESTABLISHED THE S 1/4 SEC 22 FROM 3 C.HUGHES WIT. C.HUGHES SET 1/2" IRON IN 1978 SURVEY FOR NW 1/4 OF SEC 27 (COULD NOT FIND C. H.'S IRON). CTR E-W DIRT RD 16' S. INTER. OF CTR E-W RD & CTR DRIVE TO NORTH IS S70°E, 39.5'.

I-9
REESTABLISHED SW COR SEC 23 IN AVERAGE INTER OF SAND RDS N-S-E-W. THIS FITS P.S. C. J. HUGHES CERT OF SUR INFO IN NW 1/4 OF SEC 27, DONE IN 1978.

15
ESTABLISHED THE SE COR OF THE SW 1/4 OF THE SW 1/4 OF SEC 23 PER STD BLM INSTRUCTIONS. CTR OF E-W WINDING TRAIL IS 216'± SOUTH.

C. Description of monument for corner and accessories established to perpetuate locating the position of the corner:

G-9
FOUND 1/2" SMOOTH IRON PIN W/PS CAP.

4" MAPLE	N20°W	28.35'
‡15" OAK	N75°E	34.36'
8" TWN MAPLE	S40°W	18.85'
17" R.OAK	N35°E	43.22'
‡9" MAPLE	N25°E	48.23'

H-9
SET 5/8" X 34" REROD W/CAP. NO POST SET.

‡30" B. CHERRY	N09°E	21.85'
‡14" B. CHERRY	S30°E	45.42'
5" B. CHERRY	S24°W	31.87'
‡40" OAK	S84°W	23.44'

I-9
SET 5/8" X 32" REROD W/CAP 8" BELOW GRADE. SET POST NE COR OF INTER.

3" MAPLE	S25°E	43.64'
8" R. PINE	N43°E	35.29'
8" R. PINE	N53°W	40.49'
14" TWN R.PINE	S50°W	38.89'

15
SET 5/8" X 34" REROD W/CAP & POST.

10" R. PINE	S69°W	6.96'
14" P. PINE	N07°W	40.10'
12" J. PINE	N80°E	21.38'
5" J. PINE	S06°E	25.50'

‡ = WIT. BY C.HUGHES, PS#20706 ‡ = WIT BY C. HUGHES P.S.

Signed by Carl T Kiiskila Date 3-28-97

Surveyor's Michigan License No. 33981

FORM APPROVED BY MICHIGAN STATE BOARD OF LAND SURVEYORS, JAN. 28, 1971
REVISED MAY 14, 1975
REVISED JAN., 1983