LAND CORNER RECORDATION CERTIFICATE

Filing Requirement of Act 74, Mich. P.A. 1970

For corners in MISSAUKEE (County)

	Located In:	Corner Code ##
1. Public Land Survey	T 23N R 7W	J-7,K-7
	T ___ R ___	
	T ___ R ___	
	T ___ R ___	
2. Property Controlling	S 14 T ___ R ___	12,13
in Section	S ___ T ___ R ___	
3. Miscellaneous	S ___ T ___ R ___	
Property in Sec.	S ___ T ___ R ___	

Register of Deeds Stamp & File Number

4. Lot No. _____ , Recorded Plat _____
5. Private Claims _____

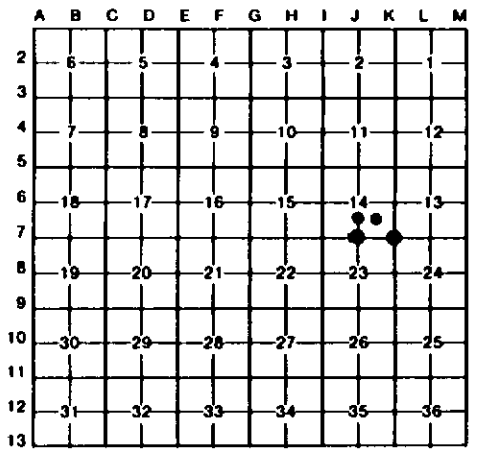

I, CARL KIISKILA , in a field survey on MARCH 30 , 19 95 , do hereby certify that under requirements of P.A. 74, Michigan P.A. of 1970, the corner points mentioned in lines 1 and 2 above were in conformance with regulations and rules therefore as required in the current manual of survey instructions of the United States Department of the Interior, Bureau of Land Management or by a decree of a Court of Law and/or that the corner points mentioned in lines 3, 4 and 5 above were in conformance with the rules of the Michigan Board of Land Surveyors or by a Decree of a Court of Law; established, re-established, monumented, re-monumented, recovered, found as expressed below:

NOTE: Not more than 4 corners, all in the same town and range, may be recorded on this certificate.

A. Description of original monument and accessories and/or subsequent restoration:

J-7 K-7 12 13

(NO EVIDENCE OF G.L.O. CORNER, B.T'S, LINE TREES & TOPOGRAPHY, AS CALLED OUT IN THE G.L.O. LINE NOTES; UNLESS NOTED IN ITEM "B" BELOW.)

STATE OF MICHIGAN
CARL KIISKILA
LAND SURVEYOR
No. 33981
LICENSED LAND SURVEYOR

B. Description of corner evidence found and/or method applied in restoring or reestablishing corner:

J-7	K-7	12	13
REESTABLISHED THE S 1/4 COR SEC 14 MIDWAY AND ON LINE BETWEEN FOUND SW COR AND REESTABLISHED SE COR. OF SEC. 14.	REESTABLISHED SW COR OF SEC 13; FROM 3 GLO STREAM TIES: 7.5 CHS(495') WEST, MEAS. 485'±; 6 CHS(396') SOUTH, MEAS. 365'±; 9 CHS(594') EAST, MEAS. 607'±. THIS LEAVES GLO DISTANCE 1 MI E, 1 MI W AND 1 MI S.	ESTABLISHED THE SW COR OF THE NW 1/4 OF THE SE 1/4 OF SEC 14; PER STD BLM INSTRUCTIONS. INTERSECTION OF N-S TRAIL RD. & DR. WEST IS N80°W 83'±.	ESTABLISHED THE SE COR OF THE NW 1/4 OF THE SE 1/4 OF SEC 14; PER STD BLM INSTRUCTIONS.

C. Description of monument for corner and accessories established to perpetuate locating the position of the corner:

J-7			K-7			12			13		
SET 1" X 72" GALV PIPE W/ALUM DNR CAP & CARSONITE POST.			SET 1" X 60" GALV PIPE W/ALUM DNR CAP & CARSONITE POST.			SET 5/8" X 32" CAPPED REBOD & CARSONITE POST.			SET 1" X 72" CAPPED PIPE & CARSONITE POST.		
10" CEDAR	N30°E	40.85'	8" CEDAR	N60°W	7.11'	6" BALSAM	S16°W	34.58'	8" CEDAR	S85°E	7.35'
9" CEDAR	NORTH	50.59'	9" CEDAR	N35°E	3.94'	8" BALSAM	S23°E	27.74'	6" CEDAR	S35°W	12.34'
3" BALSAM	S50°W	32.12'	5" CEDAR	S80°E	11.36'	4" BALSAM	N30°E	12.07'	10" CEDAR	S77°W	12.71'
7" CEDAR	S25°E	59.58'	6" CEDAR	SOUTH	8.46'	14" J. PINE	N35°W	46.05'	9" CEDAR	N41°W	10.29'

Signed by Carl T. Kiiskila Date 3-28-97

Surveyor's Michigan License No. 33981

FORM APPROVED BY MICHIGAN STATE BOARD OF LAND SURVEYORS, JAN. 28, 1971
REVISED MAY 14, 1975
REVISED JAN., 1983