LAND CORNER RECORDATION CERTIFICATE

Filing Requirement of Act 74, Mich. P.A. 1970

For corners in
MISSAUKEE
(County)

	Located In:	Corner Code #1
1. Public Land Survey	T 23N R 7W	K-6
	T ___ R ___	
	T ___ R ___	
	T ___ R ___	
2. Property Controlling	S 13 T ___ R ___	11,15
in Section	S 14 T ___ R ___	7
3. Miscellaneous	S ___ T ___ R ___	
Property in Sec.	S ___ T ___ R ___	

Register of Deeds Stamp & File Number

4. Lot No. _____ , Recorded Plat _____
5. Private Claims _____

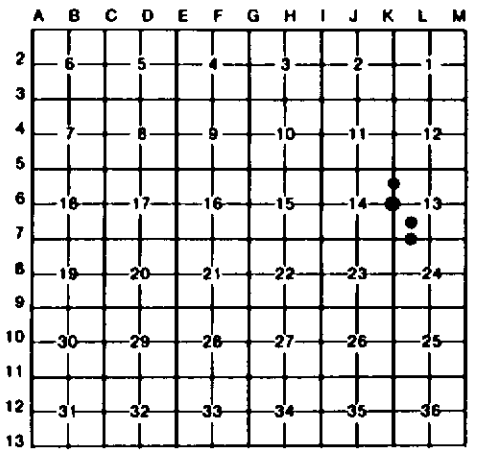

I, CARL KIISKILA , in a field survey on MARCH 30 , 19 95 , do hereby certify that under requirements of P.A. 74, Michigan P.A. of 1970, the corner points mentioned in lines 1 and 2 above were in conformance with regulations and rules therefore as required in the current manual of survey instructions of the United States Department of the Interior, Bureau of Land Management or by a decree of a Court of Law and/or that the corner points mentioned in lines 3, 4 and 5 above were in conformance with the rules of the Michigan Board of Land Surveyors or by a Decree of a Court of Law; established, re-established, monumented, re-monumented, recovered, found as expressed below:

NOTE: Not more than 4 corners, all in the same town and range, may be recorded on this certificate.

A. Description of original monument and accessories and/or subsequent restoration:

K-6 11 15 7

(NO EVIDENCE OF G.L.O. CORNER, B.T'S, LINE TREES & TOPOGRAPHY, AS CALLED OUT IN THE G.L.O. LINE NOTES; UNLESS NOTED IN ITEM "B" BELOW.)

STATE OF MICHIGAN
CARL KIISKILA
LAND SURVEYOR
No. 33981
LICENSED LAND SURVEYOR

B. Description of corner evidence found and/or method applied in restoring or reestablishing corner:

K-6
REESTABLISHED THE E 1/4 COR OF SEC 14, MIDWAY AND ON LINE BETWEEN REESTABLISHED NE AND SE CORS OF SEC 14.

11
ESTABLISHED THE NE COR OF THE SW 1/4 OF THE SW 1/4 SEC 13, PER STD BLM INSTRUCTIONS. CTR OLD ABANDONED E-W RR GRADE IS 97' SOUTH.

15
ESTABLISHED THE SE COR OF THE SW 1/4 OF THE SW 1/4 OF SEC 13, PER STD BLM INSTRUCTIONS. COR FALLS IN TAG ALDER SWAMP.

7
ESTABLISHED THE NE COR OF THE SE 1/4 OF THE NE 1/4 OF SEC 14, PER STD BLM INSTRUCTIONS. FD. OLD N-S BARB WIRE/ CEDAR POST FN REMAINS 29'± EAST.

C. Description of monument for corner and accessories established to perpetuate locating the position of the corner:

K-6
SET 4" AL DNR MON & CEDAR POST & CARSONITE POST.

8" CEDAR	S65°W	19.37'
11" CEDAR	S73°E	34.82'
11" TWN MAPLE	N50°W	23.04'
10" TWN MAPLE	N55°E	27.88'

OLD DOWN N-S FN IS EAST 23'±3'

11
SET 5/8" X 34" REROD W/PS CAP & CARSONITE POST.

7" BALSAM	S80°W	66.42'
10" B CHERRY	N45°W	48.13'
14"TRI BASSWOOD	N05°E	69.07'
30" CLUMP MAPLE	S70°E	95.34'

15
SET 1" X 84" GALV PIPE W/PS CAP & CARSONITE POST IN TAG. ALDER SWAMP.
-NO TREES FOR WIT IN VICINITY.
NWLY EDGE 5'± WIDE STREAM (COURSE SW) IS EAST 50'± 3'.
NWLY EDGE 5'± WIDE STREAM IS SOUTH 44'± 3'.
W'LY EDGE CED SWP. EAST 320'±
S'LY EDGE CED SWP. NORTH 260'±

7
SET 5/8" X 34" REROD W/PS CAP.

6" OAK	N30°W	7.23'
3" OAK	N55°E	4.81'
8" TRI MAPLE	S05°W	48.32'
11" OAK	S65°W	26.10'

Signed by Carl T Kiiskila Date 3-28-97

Surveyor's Michigan License No. 33981

FORM APPROVED BY MICHIGAN STATE BOARD OF LAND SURVEYORS, JAN. 28, 1971
REVISED MAY 14, 1975
REVISED JAN., 1983