LAND CORNER RECORDATION CERTIFICATE

Filing Requirement of Act 74, Mich. P.A. 1970

For corners in MISSAUKEE (County)

	Located In:	Corner Code #1
1. Public Land Survey	T 23N R 7W	J-6
	T R	
	T R	
	T R	
2. Property Controlling	S 14 T R	5,8,9
in Section	S T R	
3. Miscellaneous	S T R	
Property in Sec.	S T R	

Register of Deeds Stamp & File Number

4. Lot No. _____ , Recorded Plat _____
5. Private Claims _____

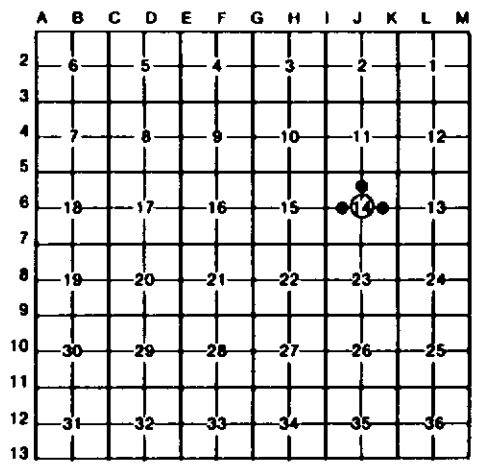

I, CARL KIISKILA , in a field survey on MARCH 29 , 19 95 , do hereby certify that under requirements of P.A. 74, Michigan P.A. of 1970, the corner points mentioned in lines 1 and 2 above were in conformance with regulations and rules therefore as required in the current manual of survey instructions of the United States Department of the Interior, Bureau of Land Management or by a decree of a Court of Law and/or that the corner points mentioned in lines 3, 4 and 5 above were in conformance with the rules of the Michigan Board of Land Surveyors or by a Decree of a Court of Law; established, re-established, monumented, re-monumented, recovered, found as expressed below:

NOTE: Not more than 4 corners, all in the same town and range, may be recorded on this certificate.

A. Description of original monument and accessories and/or subsequent restoration:

J-6 5 8 9

(NO EVIDENCE OF G.L.O. CORNER, B.T'S, LINE TREES & TOPOGRAPHY, AS CALLED OUT IN THE G.L.O. LINE NOTES; UNLESS NOTED IN ITEM "B" BELOW.)

B. Description of corner evidence found and/or method applied in restoring or reestablishing corner:

J-6	5	8	9
ESTABLISHED THE CENTER OF SEC 14, AT THE INTERSECTION OF THE TRUE 1/4 LINES, PER STANDARD SURVEY PROCEDURE FOR SUBDIVISION OF A SECTION.	ESTABLISHED THE NW COR OF THE SW 1/4 OF THE NE 1/4 OF SEC 14; PER STD BLM INSTRUCTIONS. CTR N-S TRAIL IS EAST 32'±.	ESTABLISHED THE SW COR OF THE SE 1/4 OF THE NW 1/4 OF SEC 14; PER STD BLM INSTRUCTIONS. IRON SET AT N EDGE CEDAR SWAMP.	ESTABLISHED THE NE COR OF THE NW 1/4 OF THE SE 1/4 OF SEC 14; PER STD BLM INSTRUCTIONS.

C. Description of monument for corner and accessories established to perpetuate locating the position of the corner:

J-6			5			8			9		
SET DNR MON & CARSONITE POST.			SET 5/8" X 32" CAPPED REROD & CARSONITE POST.			SET 5/8" X 32" CAPPED REROD & CARSONITE POST.			SET 5/8" X 32" CAPPED REROD & CARSONITE POST.		
4" W. PINE	EAST	26.29'	10" R. PINE	N60°W	8.16'	8" W. PINE	N80°W	24.71'	6" MAPLE	N65°E	9.75'
4" R. PINE	S13°E	34.72'	12" R. PINE	S55°W	8.85'	10" CEDAR	N12°W	29.12'	8" MAPLE	N48°W	12.10'
8" MAPLE	S37°W	14.31'	4" MAPLE	S09°E	15.77'	6" MAPLE	S64°E	8.41'	5" MAPLE	S25°W	15.36'
5-12" TRI MAPLE	N30°W	7.36'	3" MAPLE	N31°E	14.59'	4" CEDAR	N18°E	22.64'	10" TWIN MAPLE	S47°E	20.75'

Signed by Carl T. Kiiskila 33981 Date 3-28-97

Surveyor's Michigan License No. _____

FORM APPROVED BY MICHIGAN STATE BOARD OF LAND SURVEYORS, JAN. 28, 1971
REVISED MAY 14, 1975
REVISED JAN., 1983