LAND CORNER RECORDATION CERTIFICATE

Filing Requirement of Act 74, Mich. P.A. 1970

For corners in
MISSAUKEE
(County)

	Located In:	Corner Code ##
1. Public Land Survey	T 23N R 7W	6-5,H-6
	T ___ R ___	
	T ___ R ___	
	T ___ R ___	
2. Property Controlling	S 15 T ___ R ___	1
in Section	S ___ T ___ R ___	
3. Miscellaneous	S T R	
Property in Sec.	S T R	

Register of Deeds Stamp & File Number

4. Lot No. _____, Recorded Plat _____
5. Private Claims _____

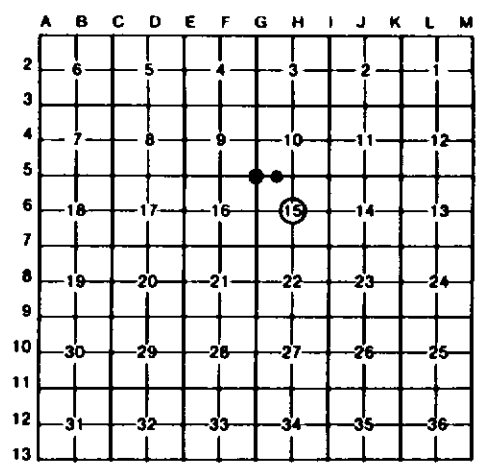

I, CARL KIISKILA, in a field survey on MAY 11, 19 95, do hereby certify that under requirements of P.A. 74, Michigan P.A. of 1970, the corner points mentioned in lines 1 and 2 above were in conformance with regulations and rules therefore as required in the current manual of survey instructions of the United States Department of the Interior, Bureau of Land Management or by a decree of a Court of Law and/or that the corner points mentioned in lines 3, 4 and 5 above were in conformance with the rules of the Michigan Board of Land Surveyors or by a Decree of a Court of Law; established, re-established, monumented, re-monumented, recovered, found as expressed below:

NOTE: Not more than 4 corners, all in the same town and range, may be recorded on this certificate.

A. Description of original monument and accessories and/or subsequent restoration:

6-5 H-6 1

(NO EVIDENCE OF G.L.O. CORNER, B.T'S, LINE TREES & TOPOGRAPHY, AS CALLED OUT IN THE G.L.O. LINE NOTES; UNLESS NOTED IN ITEM "B" BELOW.)

B. Description of corner evidence found and/or method applied in restoring or reestablishing corner:

6-5	H-6	1
ACCEPTED FD IRON FOR SW COR SEC 10 AS SET BY P.S., J. WILCOX IN 1981 SURVEY IN SEC 15. J.W. SET IRON DOUBLE PROP.	FD AND ACCEPTED IRON FOR CTR OF SEC 15 AS SET BY P.S., J. WILCOX IN 1981 SURVEY OF SEC 15. J. WILCOX SET CTR S-15 AT INTER OF 1/4 LINES.	FD IRON FOR NE COR OF NW 1/4 OF NW 1/4 OF SEC 15 AS SET BY P.S., J. WILCOX IN 1981 SURVEY IN SEC 15.

C. Description of monument for corner and accessories established to perpetuate locating the position of the corner:

6-5

FD CAPPED IRON & SET CARSONITE POST.

#8" POPLAR	S55°E	7.18'
#10" TWN POPLAR	S41°W	10.70'
#6" MAPLE	N67°W	6.99'
#6" POPLAR	N40°E	10.33'

JERRY WILCOX WITNESSES DEC. 1981.

H-6

FD CAPPED IRON.

#8" W. PINE	N03°W	3.50'
#10" W. PINE	N63°W	7.37'
#9" R. PINE	S13°W	7.07'
#6" W. PINE	S85°E	23.24'

JERRY WILCOX WITNESSES DEC. 1981.

1

FD CAPPED IRON #14102,J.WILCOX & SET CARSONITE POST.

5" MAPLE	N86 E	8.99'
9" CEDAR	S25 W	22.75'
5" MAPLE	N28 W	4.22'
5" MAPLE	N56 E	17.00'

STATE OF MICHIGAN
CARL KIISKILA
LAND SURVEYOR
No. 33981
LICENSED LAND SURVEYOR

Signed by Carl T. Kiiskila Date 3-28-97

Surveyor's Michigan License No. 33981

FORM APPROVED BY MICHIGAN STATE BOARD OF LAND SURVEYORS, JAN. 28, 1971
REVISED MAY 14, 1975
REVISED JAN., 1983