LAND CORNER RECORDATION CERTIFICATE

Filing Requirement of Act 74, Mich. P.A. 1970

For corners in
MISSAUKEE
(County)

Located In: Corner Code 77

1. Public Land Survey		T 23N	R 7W	K-4,L-4,M-4
		T	R	
		T	R	
		T	R	
2. Property Controlling	S 12	T	R	8
in Section	S	T	R	
3. Miscellaneous	S	T	R	
Property in Sec.	S	T	R	

Register of Deeds Stamp & File Number

4. Lot No. _____ , Recorded Plat _____
5. Private Claims _____

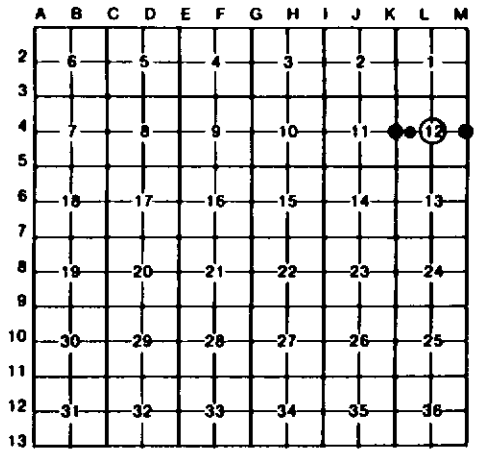

I, CARL KIISKILA , in a field survey on JUNE 8 , 19 95 , do hereby certify that under requirements of P.A. 74, Michigan P.A. of 1970, the corner points mentioned in lines 1 and 2 above were in conformance with regulations and rules therefore as required in the current manual of survey instructions of the United States Department of the Interior, Bureau of Land Management or by a decree of a Court of Law and/or that the corner points mentioned in lines 3, 4 and 5 above were in conformance with the rules of the Michigan Board of Land Surveyors or by a Decree of a Court of Law; established, re-established, monumented, re-monumented, recovered, found as expressed below:

NOTE: Not more than 4 corners, all in the same town and range, may be recorded on this certificate.

A. Description of original monument and accessories and/or subsequent restoration:

K-4 L-4 M-4 8

(NO EVIDENCE OF G.L.O. CORNER, B.T'S, LINE TREES & TOPOGRAPHY, AS CALLED OUT IN THE G.L.O. LINE NOTES; UNLESS NOTED IN ITEM "B" BELOW.)

STATE OF MICHIGAN
CARL KIISKILA
LAND SURVEYOR
No. 33981
LICENSED LAND SURVEYOR

B. Description of corner evidence found and/or method applied in restoring or reestablishing corner:

K-4
REESTABLISHED THE W1/4 COR OF SEC 12 BY SPLITTING R/W FENCES TO THE N & E WHICH SEEMS TO REPRESENT THE MOST LIKELY LOCATION OF THE ORIGINAL CORNER. COR IS IN LINE W/CTR GRV. RD E & 11.5' W OF CTR GRV. RD N. CTR 2 TRACK W IS 14' S & CTR 2 TRACK S IS 15' E.

L-4
SET THE CTR OF SEC 12, AT THE TRUE INTERSECTION OF 1/4 LINES, PER STANDARD SURVEY PROCEDURE FOR SUBDIVISION OF A SECTION. CTR OF E-W 2 TRACK IS 5' S.

M-4
REESTABLISHED THE E1/4 COR OF SEC 12 BY SPLITTING R/W FENCES TO THE N & W WHICH SEEMS TO REPRESENT THE MOST LIKELY LOCATION OF THE ORIGINAL CORNER. N-S FENCELINE IS EAST 24'. WEST FENCELINE IS NORTH 25'.

8
ESTABLISHED THE NW COR OF THE NE1/4 OF SW1/4 OF SEC. 12 PER STANDARD BLM INSTRUCTIONS.

C. Description of monument for corner and accessories established to perpetuate locating the position of the corner:

K-4
SET 5/8" REROD W/PS CAP.

8" J. PINE	S41°E	61.25'
4" MAPLE CLUMP	N16°W	20.60'
14" R. PINE	S48°W	47.60'
28" MAPLE	N85°E	112.59'
SET CARSONITE POST		
	N50°W	15.5'

L-4
SET DNR MON W/CARSONITE POST.

10" MAPLE	N28°E	7.10'
10" R. PINE	N36°W	58.68'
12" R. PINE	S37°W	32.66'
12" R. PINE	S26°E	31.92'

M-4
SET DNR MON W/CARSONITE POST.

3" R. PINE	N55°W	53.16'
6" CHERRY	S37°W	94.41'
14" W. PINE	S53°E	70.16'
CEDAR FENCE CORNER POST,		
FN. N-S-W	N50°E	34.72'

8
SET 5/8" X 34" REROD.

3" ELM	S80°W	6.92'
3" ASH	N53°W	5.67'
3" ELM	N24°E	5.22'
6" ELM	S74°E	19.55'
CTR OLD RD BED	NORTH	3'

Signed by Carl T. Kiiskila Date 3-28-97

Surveyor's Michigan License No. 33981

FORM APPROVED BY MICHIGAN STATE BOARD OF LAND SURVEYORS, JAN. 28, 1971
REVISED MAY 14, 1975
REVISED JAN., 1983