LAND CORNER RECORDATION CERTIFICATE

Filing Requirement of Act 74, Mich. P.A. 1970

For corners in
MISSAUKEE
(County)

	Located In:	Corner Code #1
1. Public Land Survey	T 23N R 7W	6-2,H-3,H-2
	T R	
	T R	
	T R	
2. Property Controlling	S 10 T R	2
in Section	S T R	
3. Miscellaneous	S T R	
Property in Sec.	S T R	

Register of Deeds Stamp & File Number

4. Lot No. _____ , Recorded Plat _____
5. Private Claims _____

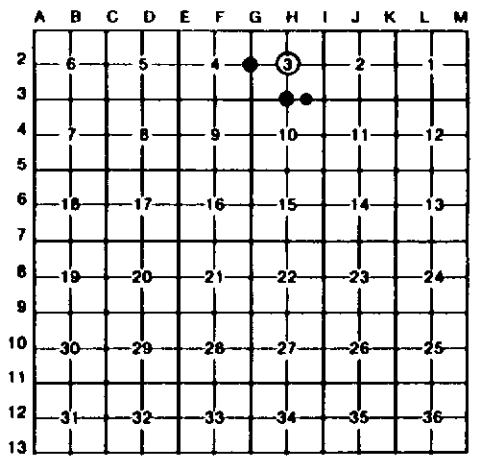

I, CARL KIISKILA, in a field survey on MAY 16, 19 95, do hereby certify that under requirements of P.A. 74, Michigan P.A. of 1970, the corner points mentioned in lines 1 and 2 above were in conformance with regulations and rules therefore as required in the current manual of survey instructions of the United States Department of the Interior, Bureau of Land Management or by a decree of a Court of Law and/or that the corner points mentioned in lines 3, 4 and 5 above were in conformance with the rules of the Michigan Board of Land Surveyors or by a Decree of a Court of Law; established, re-established, monumented, re-monumented, recovered, found as expressed below:

NOTE: Not more than 4 corners, all in the same town and range, may be recorded on this certificate.

A. Description of original monument and accessories and/or subsequent restoration:

S-2 H-3 H-2 2

(NO EVIDENCE OF G.L.O. CORNER, B.T'S, LINE TREES & TOPOGRAPHY, AS CALLED OUT IN THE G.L.O. LINE NOTES; UNLESS NOTED IN ITEM "B" BELOW.)

B. Description of corner evidence found and/or method applied in restoring or reestablishing corner:

6-2
REESTABLISHED THE W1/4 COR OF SEC 3. ON LINE ACROSS FOUND CTR. AND E1/4 COR OF SEC. 3 AND IN LINE W/CTR. OF B.TOP ROAD TO NORTH AND APPROX. LINE W/FN. SOUTH (FN. IS SOME 800'± SOUTH OF CORNER). CTR. OF E-W B.TOP ROAD IS 4' SOUTH, R.O.W. FENCE TO NORTH IS 25'± EAST (FN. IS ON E. EDGE OF ROW OF LARGE MAPLE TREES).

H-3
REESTABLISHED N 1/4 COR SEC 10 MIDWAY BETWEEN FOUND SEC COR'S. 1/2 MILE TO E & W AND IN APPROX. CTR OF E-W B.TOP ROAD.

H-2
ACCEPTED FD OLD 1/4" X 2 1/4" FLAT IRON FOR CTR S-3, ADDED 5/8" REROD. OLD R/W FN ELY IS 25' +/- SOUTH. OLD FN REMAINS TO N & E IS 23'+/- N.

2
ESTABLISHED NE COR OF NW 1/4 OF NE 1/4 OF SEC 10 PER STANDARD BLM INSTRUCTIONS.

C. Description of monument for corner and accessories established to perpetuate locating the position of the corner:

6-2
SET 5/8" X 32" CAP REROD.
PHONE RISER POST S57°W 39.77'
6" ELM N55°W 44.34'
10" MAPLE S10°W 60.45'
MAIL BOX POST S68°E 39.38'

H-3
SET 5/8" X 16" CAP REROD & CARSONITE POST.
4" OAK N04°E 54.90'
10" HEMLOCK S38°E 51.90'
12" HEMLOCK N31°W 63.83'
12" HEMLOCK S57°W 79.99'
SET CARSONITE POST SOUTH 33'

H-2
SET 5/8" X 32" CAP REROD BESIDE FD IRON PLATE.
14" CHERRY N50°E 30.85'
10" CHERRY N08°E 90.43'
8" ELM S77°W 59.40'
FENCE POST S34°W 30.53'
CTR E-W DIRT RD IS SOUTH 2'

2
SET 5/8" X 16" CAP REROD & CARSONITE POST.
POWER POLE N14°E 35.93'
MAIL BOX POST (#2300)
N67°W 57.08'
12" R. PINE S47°W 68.55'
10" TWN MAPLE S10°E 55.48'
CTR E-W B.TOP RD NORTH 1'
SET CARSONITE POST SOUTH 33'

Signed by _____ Date _____

Surveyor's Michigan License No. 33981

FORM APPROVED BY MICHIGAN STATE BOARD OF LAND SURVEYORS, JAN. 28, 1971
REVISED MAY 14, 1975
REVISED JAN., 1983