LAND CORNER RECORDATION CERTIFICATE

Filing Requirement of Act 74, Mich. P.A. 1970

For corners in MISSAUKEE (County)

	Located In:	Corner Code #
1. Public Land Survey	T 23N R 7W	J-1
	T ___ R ___	
	T ___ R ___	
	T ___ R ___	
2. Property Controlling	S 2 T ___ R ___	1
in Section	S ___ T ___ R ___	
3. Miscellaneous	S ___ T ___ R ___	
Property in Section	S ___ T ___ R ___	

Register of Deeds Stamp & File Number

4. Lot No. _____, Recorded Plat _____
5. Private Claims _____

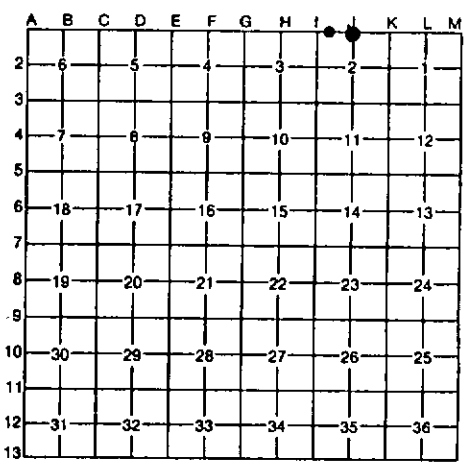

I, CARL T. KIISKILA, in a field survey on JANUARY 15, 19 97, do hereby certify that under requirements of P.A. 74, Michigan P.A. of 1970, the corner points mentioned in lines 1 and 2 above were in conformance with regulations and rules therefore as required in the current manual of survey instructions of the United States Department of the Interior, Bureau of Land Management or by a decree of a Court of Law and/or that the corner points mentioned in lines 3, 4 and 5 above were in conformance with the rules of the Michigan Board of Professional Surveyors or by a Decree of a Court of Law; established, re-established, monumented, re-monumented, recovered, found as expressed below:

NOTE: Not more than 4 corners, all in the same town and range, may be recorded on this certificate.

A. Description of original monument and accessories and/or subsequent restoration:

J-1 J-1 CONT. 1

(NO EVIDENCE OF G.L.O. CORNER, B.T'S, LINE TREES & TOPOGRAPHY, AS CALLED OUT IN THE G.L.O. LINE NOTES; UNLESS NOTED IN ITEM "B" BELOW.)

B. Description of corner evidence found and/or method applied in restoring or reestablishing corner:

J-1

FD. 1/2" PIPE IN CTR OF E-W-S GRAVEL RD'S FOR 1/4 COR COMMON TO SEC'S 2, T23N-R7W & S-35, T24N-R7W. COR FOUND AND RECORDED BY P.S. #21996, F. THOMSON IN 1979, P. 573 OF L.C.R.C'S (HE CALLED IT A 5/8" PIPE). COR ALSO USED BY PS #35993, W.GRIFFIN, CERT OF SUR IN SE1/4 S-34, T24N-R7W, L.279 P.745. CORNER FITS OCCUPANCY IN AREA; -- CONT TO RIGHT -

J-1 CONT.

R.O.W. FENCE E'LY IS 27' N, B.WIRE FN REMAINS IN GROUND TO E-W IS 27'+/- 6' SOUTH, ROW OF LARGE MAPLES TO WEST IS 29'+/- 10' S, LOOKING WEST 50'+/- ARE 2 OLD CEDAR POST REMAINS ON GROUND 33'+/- 6' NORTH. J.G.CAVANAGH (1909) HAD 2 WIT; SUGAR 3 SW 53.1 & BEECH 5 NW 65.3 - NO SIGN OF EITHER WIT.

1

ESTABLISHED THE NE COR OF FRL NW1/4 OF FRL NW1/4 OF SEC 2 PER STANDARD BLM PROCEDURE.

C. Description of monument for corner and accessories established to perpetuate locating the position of the corner:

J-1

FD 1/2" X 28" GALV. IRON PIPE.
FD OLD 1 3/16" DIA. (3/4" DIA. ON BOTTOM) X 30" LONG IRON &
RING OF STONE S03 E 17.71'
‡ 32" SUG.MAPLE N50°W 61.00' — DR SPIKE & TAG NE SIDE FD NAIL
‡ 8" SUG.MAPLE N30°E 46.20' — DR SPIKE & TAG E SIDE FD NAIL
8" R.PINE S30°W 88.10' — DROVE SPIKE & TAG NW SIDE
‡TEL.POLE S60°W 72.00' — FOUND NAIL SE SIDE.
FD 1/2" ROD W/PS CAP N. 33.05'
‡ = PS F.THOMSON 1979 WIT.

J-1 CONT.

1

SET 5/8"x 32" REROD W/PS CAP.
8" MAPLE S32°W 36.42'
5" MAPLE S48°E 46.12'
P.POLE N23°E 33.08'
20"MAPLE N36°W 66.02'
SET POST SOUTH 33'
COR IS 2' SOUTH OF CTR E-W GRAVEL ROAD.

STATE OF MICHIGAN
CARL KIISKILA
LAND SURVEYOR
No. 33981
LICENSED LAND SURVEYOR

Signed by Carl T. Kiiskila Date 4-10-97

Surveyor's Michigan License No. 33981

FORM APPROVED BY MICHIGAN STATE BOARD OF PROFESSIONAL SURVEYORS, JAN. 26, 1971
REVISED MAY 14, 1975
REVISED JAN., 1983