

**SURVEY &  
REMONUMENTATION**

LIBER 291 PAGE 452

993

APR 24 1995

**LAND CORNER RECORDATION CERTIFICATE**  
Filing Requirement of Act 74, Mich. P.A. 1970

For corners of **COMMISSION**

	<u>Missaukee</u> (County)	Located In:	Corner Code #
1. Public Land Survey		<u>T23N 7W</u>	<u>A-13</u>
		T _____ R _____	_____
		T _____ R _____	_____
		T _____ R _____	_____
2. Property Controlling in Section	S _____	T _____ R _____	_____
	S _____	T _____ R _____	_____
3. Miscellaneous Property in Sec.	S _____	T _____ R _____	_____
	S _____	T _____ R _____	_____

MISSAUKEE COUNTY MICHIGAN

RECORDED JAN 23 1995 12:01 PM

*Carolyn Flare*  
REGISTER

Register of Deeds Stamp & File Number

4. Lot No. \_\_\_\_\_, Recorded Plat \_\_\_\_\_  
5. Private Claims \_\_\_\_\_

	A	B	C	D	E	F	G	H	I	J	K	L	M
2	6	5	4	3	2	1							
3													
4	7	8	9	10	11	12							
5													
6	18	17	16	15	14	13							
7													
8	19	20	21	22	23	24							
9													
10	30	29	28	27	26	25							
11													
12	31	32	33	34	35	36							
13													

I, Daniel E. Schripsema a field survey on December, 19 94, do hereby certify that under requirements of P.A. 74, Michigan P.A. of 1970, the corner points mentioned in lines 1 and 2 above were in conformance with regulations and rules therefore as required in the current manual of survey instructions of the United States Department of the Interior, Bureau of Land Management or by a decree of a Court of Law and/or that the corner points mentioned in lines 3, 4 and 5 above were in conformance with the rules of the Michigan Board of Land Surveyors or by a Decree of a Court of Law; established, re-established, monumented, re-monumented, recovered, found as expressed below:

**NOTE: Not more than 4 corners, all in the same town and range, may be recorded on this certificate.**

A. Description of original monument and accessories and/or subsequent restoration:

- A-13) 1836 GLO Post by John Brink, Deputy Surveyor  
no witnesses given
  - A-13) 1909 Richardson notes perpetuated by Bronnel  
N 28 W, 93.5' Tel. Pole  
S 68 E, 173' 4" Blk. Oak
- Cont' on back

B. Description of corner evidence found and/or method applied in restoring or reestablishing corner:

- A-13) Section corner common to Section 31, T23N, R7W and Section 36, T23N, R8W.

Found 1/2" Iron located 1.6' West of centerline of North-South road and in the centerline of the East-West road. Accepted as a careful and faithful perpetuation of the position of the original corner.


C. Description of monument for corner and accessories established to perpetuate locating the position of the corner:

- A-13) Set 2 1/2" brass Missaukee County monument on existing 1/2" iron and installed monument box.  
S 34 W-42.37-P.Pole  
N 54 W-30.90-P.Pole  
N 71 E-103.98-28" Oak  
S 60 E-53.76-28" W. Oak

Peer Group Reviewed and Approved

Date: 1-12-94  
*J. Dean Geers*  
J. Dean Geers, Missaukee Co. Representative

Signed by Daniel E. Schripsema  
Surveyor's Michigan License No. 24617

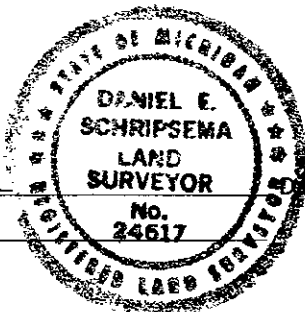

Date 1-12-95