

**SURVEY &
REMONUMENTATION**

LIBER 291 PAGE 450

APR 24 1995

**LAND CORNER RECORDATION CERTIFICATE
Filing Requirement of Act 74, Mich. P.A. 1970**

992

For corners in **COMMISSION**

| | | | |
|---|--------------------------|-------------|---------------|
| <u>Missaukee</u> <small>(County)</small> | | Located In: | Corner Code # |
| 1. Public Land Survey | T <u>23N</u> R <u>7W</u> | | <u>B-13</u> |
| | T _____ R _____ | | _____ |
| | T _____ R _____ | | _____ |
| 2. Property Controlling in Section | S _____ T _____ R _____ | | _____ |
| | S _____ T _____ R _____ | | _____ |
| 3. Miscellaneous Property in Sec. | S _____ T _____ R _____ | | _____ |
| | S _____ T _____ R _____ | | _____ |

MISSAUKEE COUNTY MICHIGAN

RECORDED **JAN 23 1995** 12:01 PM

Roslyn Flare

Register of Deeds Stamp & File Number

4. Lot No. _____, Recorded Plat _____
5. Private Claims _____

| | A | B | C | D | E | F | G | H | I | J | K | L | M |
|----|----|----|----|----|----|----|---|---|---|---|---|---|---|
| 2 | 6 | 5 | 4 | 3 | 2 | 1 | | | | | | | |
| 3 | | | | | | | | | | | | | |
| 4 | 7 | 8 | 9 | 10 | 11 | 12 | | | | | | | |
| 5 | | | | | | | | | | | | | |
| 6 | 16 | 17 | 16 | 15 | 14 | 13 | | | | | | | |
| 7 | | | | | | | | | | | | | |
| 8 | 19 | 20 | 21 | 22 | 23 | 24 | | | | | | | |
| 9 | | | | | | | | | | | | | |
| 10 | 30 | 29 | 28 | 27 | 26 | 25 | | | | | | | |
| 11 | | | | | | | | | | | | | |
| 12 | 31 | 32 | 33 | 34 | 35 | 36 | | | | | | | |
| 13 | | | | | | | | | | | | | |

I, Daniel E. Schripsema a field survey on December 19 94, do hereby certify that under requirements of P.A. 74, Michigan P.A. of 1970, the corner points mentioned in lines 1 and 2 above were in conformance with regulations and rules therefore as required in the current manual of survey instructions of the United States Department of the Interior, Bureau of Land Management or by a decree of a Court of Law and/or that the corner points mentioned in lines 3, 4 and 5 above were in conformance with the rules of the Michigan Board of Land Surveyors or by a Decree of a Court of Law; established, re-established, monumented, re-monumented, recovered, found as expressed below:

NOTE: Not more than 4 corners, all in the same town and range, may be recorded on this certificate.

A. Description of original monument and accessories and/or subsequent restoration:

- B-13) 1836 GLO post by John Brink, Deputy Surveyor Hemlock 8 N 87 W 8, Sugar 11 N 37 1/2 E 39
 - B-13) Undated W.D. Richardson field notes:
Perpetuated by driving bolt 5/8"x18"
no witnesses given.
 - B-13) 1909 F.W. Hastings
Corner Fence Post N45E 71
- Cont' on back

B. Description of corner evidence found and/or method applied in restoring or reestablishing corner:

- B-13) Quarter corner common to Section 31, T23N, R7W and Section 6, T22N, R7W.

Found 3/4" O.D. Pipe in monument box per Liber 1, page 578 and is accepted as a careful and faithful reestablishment of the position of the original corner. Corner is located 3.0' East of the centerline of the North-South road and 2.7' North of the center line of the East-West road.

C. Description of monument for corner and accessories established to perpetuate locating the position of the corner:


- B-13) Set 2 1/2" Missaukee County monument on existing 3/4" pipe.

- S 01 W 86.81' 30" Beech
- S 46 W 90.99' P.Pole
- N 45 W 47.50' P.Pole
- N 33 E 53.31' Tel. Ped. Pole

Peer Group Reviewed and Approved

Date: 11-2-94
J. Dean Geers
J. Dean Geers, Missaukee Co. Representative

Signed by Daniel E. Schripsema
Surveyor's Michigan License No. 24617

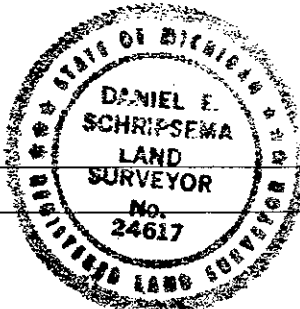

Date 12-30-94