

**SURVEY &
REMONUMENTATION**

LIBER 291 PAGE 446

989

APR 24 1995

**LAND CORNER RECORDATION CERTIFICATE
Filing Requirement of Act 74, Mich. P.A. 1970**

For corners in **COMMISSION**

<u>Missaukee</u> <small>(County)</small>	Located In:	Corner Code #
	<u>23N 7W</u>	<u>E-13</u>
1. Public Land Survey	T _____ R _____	_____
	T _____ R _____	_____
	T _____ R _____	_____
	T _____ R _____	_____
2. Property Controlling in Section	S _____ T _____ R _____	_____
	S _____ T _____ R _____	_____
3. Miscellaneous Property in Sec.	S _____ T _____ R _____	_____
	S _____ T _____ R _____	_____

MISSAUKEE COUNTY MICHIGAN
RECORDED JAN 23 1995 12:01 PM
Paulyn Flare
Register of Deeds Stamp & File Number

4. Lot No. _____, Recorded Plat _____
5. Private Claims _____

A	B	C	D	E	F	G	H	I	J	K	L	M
2	6	5	4	3	2	1						
3												
4	7	8	9	10	11	12						
5												
6	18	17	16	15	14	13						
7												
8	19	20	21	22	23	24						
9												
10	30	29	28	27	26	25						
11												
12	31	32	33	34	35	36						
13												

I, Daniel E. Schripsema a field survey on December, 19 94, do hereby certify that under requirements of P.A. 74, Michigan P.A. of 1970, the corner points mentioned in lines 1 and 2 above were in conformance with regulations and rules therefore as required in the current manual of survey instructions of the United States Department of the Interior, Bureau of Land Management or by a decree of a Court of Law and/or that the corner points mentioned in lines 3, 4 and 5 above were in conformance with the rules of the Michigan Board of Land Surveyors or by a Decree of a Court of Law; established, re-established, monumented, re-monumented, recovered, found as expressed below:

NOTE: Not more than 4 corners, all in the same town and range, may be recorded on this certificate.

A. Description of original monument and accessories and/or subsequent restoration:

- E-13) 1836 GLO post by John Brink, Deputy Surveyor
Beech 10 N 17 W 57, Beech 10 N 22 1/2 E 56
- E-13) Undated Missaukee County survey records, Field Book 35
SW Corner Sec. 33 Cor F. Post South 50
- E-13) 1940 MDOT Plans, Project #57-1, File #S-29-A-3
Wooded stake with witnesses

B. Description of corner evidence found and/or method applied in restoring or reestablishing corner:

E-13) Section corner common to Sections 32 and 33

Found 5/8" Iron (flared) in monument box. No previous record as to the origin of the Iron could be located. The corner is located 24.0' East of the centerline of the North-South road and 0.9' North of the East-West road. Accepted as a careful and faithful perpetuation of the position of the original corner.


C. Description of monument for corner and accessories established to perpetuate locating the position of the corner:

E-13) Raised existing iron in monument box with 5/8" iron with 2 1/2" brass Missaukee County monument.

S 01 W 50.99' Top of Conc. R.O.W. Marker
N 45 E 64.47' Tel. Ped. Post
N 22 W 119.16' P.Pole
N 70 W 126.45' Tel. Ped. Post

Peer Group Reviewed and Approved
Date: 11-2-94
J. Dean Beers
J. Dean Beers, Missaukee Co. Representative

Signed by Daniel E. Schripsema
Surveyor's Michigan License No. 24617

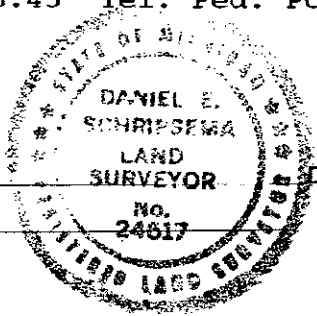

Date 12-30-94