

**SURVEY &  
REMONUMENTATION**

LIBER 291 PAGE 441

986

APR 24 1995

**LAND CORNER RECORDATION CERTIFICATE**  
Filing Requirement of Act 74, Mich. P.A. 1970

For corners @ **COMMISSION**  
**Missaukee**  
(County)

Located In: Corner Code #

- |                                    |   |            |           |             |
|------------------------------------|---|------------|-----------|-------------|
|                                    |   | <b>23N</b> | <b>7W</b> | <b>H-13</b> |
| 1. Public Land Survey              | T | _____      | R         | _____       |
|                                    | T | _____      | R         | _____       |
|                                    | T | _____      | R         | _____       |
|                                    | T | _____      | R         | _____       |
| 2. Property Controlling in Section | S | _____      | T         | _____       |
|                                    | S | _____      | T         | _____       |
| 3. Miscellaneous Property in Sec.  | S | _____      | T         | _____       |
|                                    | S | _____      | T         | _____       |

MISSAUKEE COUNTY MICHIGAN

RECORDED **JAN 23 1995 12<sup>01</sup> PM**

*Paulyn Klare*

Register of Deeds Stamp & File Number

4. Lot No. \_\_\_\_\_, Recorded Plat \_\_\_\_\_  
5. Private Claims \_\_\_\_\_

	A	B	C	D	E	F	G	H	I	J	K	L	M
2	6		5		4		3		2		1		
3													
4	7		8		9		10		11		12		
5													
6	18		17		16		15		14		13		
7													
8	19		20		21		22		23		24		
9													
10	30		29		28		27		26		25		
11													
12	31		32		33		34		35		36		
13													

I, Daniel E. Schripsema a field survey on December, 19 94, do hereby certify that under requirements of P.A. 74, Michigan P.A. of 1970, the corner points mentioned in lines 1 and 2 above were in conformance with regulations and rules therefore as required in the current manual of survey instructions of the United States Department of the Interior, Bureau of Land Management or by a decree of a Court of Law and/or that the corner points mentioned in lines 3, 4 and 5 above were in conformance with the rules of the Michigan Board of Land Surveyors or by a Decree of a Court of Law; established, re-established, monumented, re-monumented, recovered, found as expressed below:

**NOTE: Not more than 4 corners, all in the same town and range, may be recorded on this certificate.**

A. Description of original monument and accessories and/or subsequent restoration:

- H-13) 1836 GLO Quarter Section Post by John Brink, Deputy Surveyor,  
Sugar 14 N79 1/2E 19  
Sugar 10 N67W 42
  - H-13) 1889 Hastings, Field Book 14  
T Rail  
Sugar 10 N40W 85  
Beech 11 N21W 57 1/2
- Cont' on Back

B. Description of corner evidence found and/or method applied in restoring or reestablishing corner:

- H-13) Quater corner common to Section 34, T23N, R7W and Section 3, T22N, R7W.

Found 1/2" rerod/cap per LCRC Liber 1, Page 813. Corner was 22.4 South of M-55 centerline. Accepted as a careful and faithful reestablishment of the position of the original corner.

C. Description of monument for corner and accessories established to perpetuate locating the position of the corner:


- H-13) Set 2 1/2" brass Missaukee County monument on existing 1/2" rod.  
N 02 W 74.65 14" Beech  
S 31 E 63.0 NE corner stone house  
11' West of West edge stone house  
S 60 E 55.10 Tel. Pole  
22.4' South of M-55 Centerline

Peer Group Reviewed and Approved

Date: 12-21-94

*J. Dear Geers*  
J. Dear Geers, Missaukee Co. Representative

Signed by Daniel E. Schripsema  
Surveyor's Michigan License No. 24617

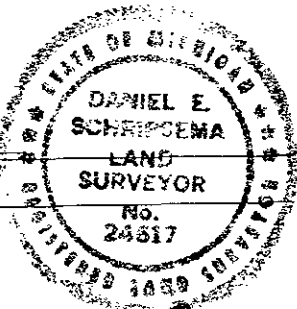

Date 12-30-94