

**SURVEY &
REMONUMENTATION**

LIBER 291 PAGE 439

985

APR 24 1995

LAND CORNER RECORDATION CERTIFICATE
Filing Requirement of Act 74, Mich. P.A. 1970

For corners **COMMISSION**
Missaukee
(County)

Located In: Corner Code #

		23N	7W	I-13
1. Public Land Survey	T	_____	R	_____
	T	_____	R	_____
	T	_____	R	_____
	T	_____	R	_____
2. Property Controlling In Section	S	_____	T	_____
	S	_____	T	_____
3. Miscellaneous Property in Sec.	S	_____	T	_____
	S	_____	T	_____

MISSAUKEE COUNTY MICHIGAN

RECORDED JAN 23 1995 12⁰¹ PM

Paula Flare
Register of Deeds Stamp & File Number

4. Lot No. _____, Recorded Plat _____
5. Private Claims _____

	A	B	C	D	E	F	G	H	I	J	K	L	M
2	6		5		4		3		2		1		
3													
4	7		8		9		10		11		12		
5													
6	18		17		16		15		14		13		
7													
8	19		20		21		22		23		24		
9													
10	30		29		28		27		26		25		
11													
12	31		32		33		34		35		36		
13													

I, Daniel E. Schripsema a field survey on December, 19 94, do hereby certify that under requirements of P.A. 74, Michigan P.A. of 1970, the corner points mentioned in lines 1 and 2 above were in conformance with regulations and rules therefore as required in the current manual of survey instructions of the United States Department of the Interior, Bureau of Land Management or by a decree of a Court of Law and/or that the corner points mentioned in lines 3, 4 and 5 above were in conformance with the rules of the Michigan Board of Land Surveyors or by a Decree of a Court of Law; established, re-established, monumented, re-monumented, recovered, found as expressed below:

NOTE: Not more than 4 corners, all in the same town and range, may be recorded on this certificate.

A. Description of original monument and accessories and/or subsequent restoration:

- I-13) 1836 GLO Section Post by John Brink, Deputy Surveyor
Sugar 14 N57E 20 & Sugar 12 N47W 31
- I-13) 1890 & 1891 Richardson Field Book 14, Section 35.
- I-13) 1911 Beuthian, Section 3,
Iron Pipe
Cherry 14 N5W 67
Maple 6 S55W 96

Cont' on Back

B. Description of corner evidence found and/or method applied in restoring or reestablishing corner:

- I-13) Found 1/2" rod/cap per LCRC Recorded Liber S-1, Page 813. Corner is 2.3' South of centerline and centerline of N & S roads. Accepted as a careful and faithful reestablishment of the position of the original corner.

C. Description of monument for corner and accessories established to perpetuate locating the position of the corner:

- I-13) Replace existing 1/2" Iron with 1/2" Iron with 2 1/2" brass Missaukee County monument and monument box.


N 24 W 60.24 P. Pole
N 20 E 83.20 30" Maple
S 31 E 52.90 Sign Post
S 44 W 54.00 Sign Post

Peer Group Reviewed and Approved

Date: 12-21-94

J. Dean Geers, Missaukee Co. Representative

Signed by Daniel E. Schripsema
Surveyor's Michigan License No. 24617

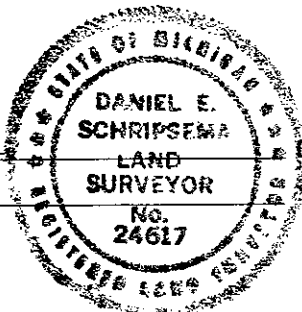

Date 12-30-94