


**LAND CORNER RECORDATION CERTIFICATE**  
Filing Requirement of Act 74, Mich. PA 1970

For Corners In: Missaukee (County)	Located In	Corner Code #
1. Public Land Survey	T <u>23N</u> R <u>7W</u> <u>C8</u>	
	T _____ R _____	
2. Property Controlling in Section	S _____ T _____ R _____	
	S _____ T _____ R _____	
3. Miscellaneous Property in Section	S _____ T _____ R _____	
	S _____ T _____ R _____	

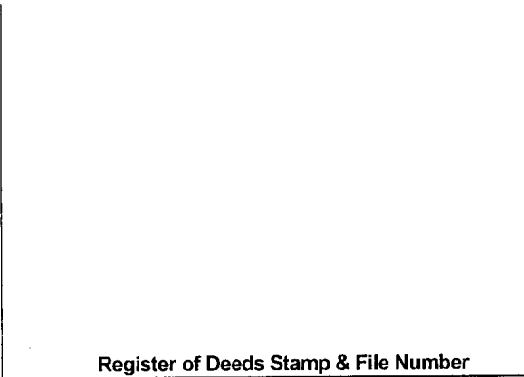


4. Lot No: \_\_\_\_\_ Recorded Plat: \_\_\_\_\_

5. Private Claims: \_\_\_\_\_

I, Craig W. McVean, in a field survey on May 8, 2007 do hereby state that under requirements of PA 74, Michigan PA of 1970, the corner points mentioned in lines 1 and 2 above were in conformance with regulations and rules therefore as required in the current manual of survey instructions of the United States Department of the Interior, Bureau of Land Management or by a decree of a Court of Law and/or that the corner points mentioned in lines 3, 4 and 5 above were in conformance with the rules of the Michigan Board of Land Surveyors or by a Decree of a Court of Law; established, re-established, monumented, recovered, found as expressed below:

**NOTE: Not more than 2 corners, all in the same town and range, may be recorded on this certificate.**

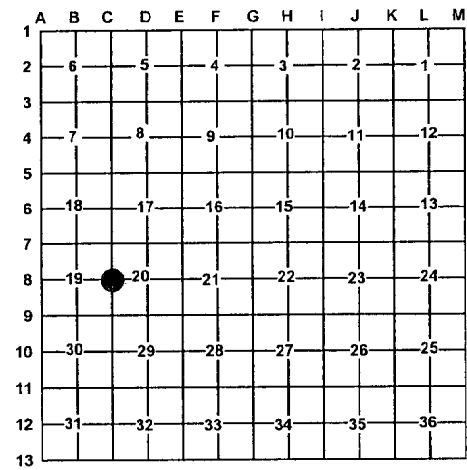

A. Description of original monument and accessories and/or subsequent restoration:

- C8 – 1853 – GLO – T. Whelpley – Set ¼ Post
- 1) W. Pine 6 S65¼°W 25 L.
  - 2) W. Pine 14 N 7°E 24 L.
  - 1892 – 1914 – CSR – FB# 35, p. 55 – E. A. Beuthien - OB OK.
  - NB. 3) YPS 16 N40°E 35 L.
  - 4) YPS 20 S69°E 82 L.
  - **No Date** – CSR - FB# 35, p. 42 – 1<sup>st</sup> BT gone, 2<sup>nd</sup> BT is dead
  - NBT's: 5) R. Oak 16" N63½°E 53
  - 6) Nor. Pine 12" S4½°W 23

B. Description of corner evidence found and/or method applied in restoring or re-establishing corner:

C8 –¼ Corner common to Sections 19 & 20, T23N, R7W - Searched area for evidence and found 16" Yellow Pine Stump being apparent witness (#3). Dug at record bearing and distance, no stake evident, but position is 33'± West of corner for fence remains and field rows East & North. All other BT's are gone. Set 4" Aluminum DNR cap on 1" x 36" galvanized iron pipe at record bearing and distance from found Pine stump (#3). DNR monument is accepted as a careful and faithful perpetuation of the position of the original corner.

C. Description of monument for corner and accessories established to perpetuate locating the position of the corner:

- C8 – Stamped 4" Aluminum DNR Cap on 1" x 36" galvanized iron pipe with broken glass bottles at base and placed ring of stones around top.
- N2°E 12.86' to set nail and tag in East side 5" Oak scribed 'XBT'
  - S79°E 32.67' to set nail and tag in North side 8" Oak scribed 'XBT'
  - S46°E 83.90' to set nail and tag in Northeast side 13" Red Pine scribed 'XBT'
  - N85°W 52.68' to set nail and tag in North side 5" Oak scribed 'XBT'
  - N40°E 23.80' to set 60d nail in centerline 16" Yellow Pine Stump (#3)
  - Set Blue Carsonite Post 1' Southwest



Signed by: Craig W. McVean  
Surveyor's Michigan License No.: 39088

Date: 11/24/2008