


LAND CORNER RECORDATION CERTIFICATE
Filing Requirement of Act 74, Mich. PA 1970

For Corners In: Missaukee (County)	Located In	Corner Code #
1. Public Land Survey	T <u>23N</u> R <u>7W</u> <u>D7</u>	
	T _____ R _____	
2. Property Controlling in Section	S _____ T _____ R _____	
	S _____ T _____ R _____	
3. Miscellaneous Property in Section	S _____ T _____ R _____	
	S _____ T _____ R _____	
4. Lot No: _____	Recorded Plat: _____	
5. Private Claims: _____		

Register of Deeds Stamp & File Number

I, Craig W. McVean, in a field survey on Aug. 8, 2007 do hereby state that under requirements of PA 74, Michigan PA of 1970, the corner points mentioned in lines 1 and 2 above were in conformance with regulations and rules therefore as required in the current manual of survey instructions of the United States Department of the Interior, Bureau of Land Management or by a decree of a Court of Law and/or that the corner points mentioned in lines 3, 4 and 5 above were in conformance with the rules of the Michigan Board of Land Surveyors or by a Decree of a Court of Law; established, re-established, monumented, recovered, found as expressed below:

NOTE: Not more than 2 corners, all in the same town and range, may be recorded on this certificate.

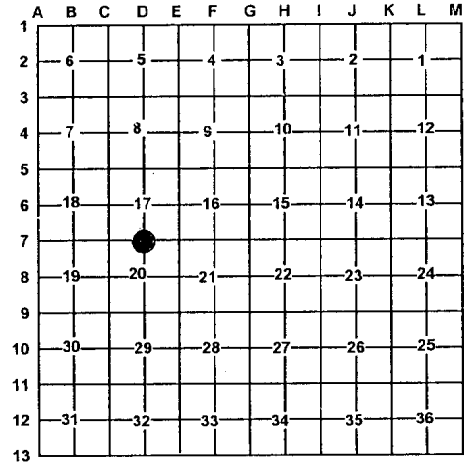

A. Description of original monument and accessories and/or subsequent restoration:

- | | |
|---|--|
| <u>D7</u> - 1853 - GLO - T. Whelpley - Set 1/4 Post | - 1982 - LCRC #666 - J. L. Wilcox - Set iron and cap from GLO witnesses. |
| 1) N. Pine 14" N54°W 26 L. | 7) N32°W 24" Oak 36.65' |
| 2) N. Pine 12" S23°W 23 L. | 8) N09°W 18" Oak 59.57' |
| - 1890 - CSR - FB #35, p. 66 | 9) S15°W 8" Maple 29.15' |
| 3) YPS 16" N82°E 32 L. | 10) N28°E 24" Maple 23.03 |
| 4) YPS 20" S68°W 79 L. | |
| 5) B. Oak 3" S06°E 126 L. | |
| - 1892 & 1914 - CSR - E. A. Beuthein, FB #35, p. 56 | |
| 6) WPS 24" S22°W 78 L. | |

B. Description of corner evidence found and/or method applied in restoring or re-establishing corner:

D7 - 1/4 corner common to Sections 17 & 20, T23N, R7W - No conclusive evidence of Witnesses #1 through #6. Set 4" DNR Aluminum cap on 1" x 36" galvanized iron pipe with 4" x 1' PVC and concrete around cap by single proportion to GLO which fits E. A. Beuthein's East-West dimension closely. Falls in cleared area where all stumps have been removed. Measured Grid distance of S87°14'57"E 2673.36' (2640' - GLO, 2676.30' - EAB) to 'E7' and N87°14'57"W 2673.36' (2640' - GLO, 2676.30' - EAB) to 'C7'. DNR monument is accepted as a careful and faithful re-establishment of the position of the original corner.

Reference Pt. - Fd. 1/2" capped iron rod #14102 per Wilcox LCRC #666 and witnesses #7 thru #10 that is S52°11'W 85.95' from 'D7'. No evidence of GLO witnesses here. Two Pine stumps here would sort of fit 1/2" CIR if you transposed GLO bearings but no reason to believe this is case. No CSR Witnesses would fit this location. 1/2" CIR not utilized as 'D7' in this survey.

C. Description of monument for corner and accessories established to perpetuate locating the position of the corner:

D7 - Stamped 4" DNR Aluminum cap on 1" X 36" galvanized iron pipe with 4" x 1' PVC with concrete around cap.
N85°W 81.26' to set nail and tag in North side 27" White Oak
N20°E 47.05' to set nail and tag in West side 8" Cherry
S10°E 65.41' to set nail and tag in Northeast side 9" Red Pine scribed 'XBT'
S51°E 91.41' to set nail and tag in Northeast side 16" Red Pine scribed 'XBT'
S52°11'W 85.95' to found 1/2" capped iron rod #14102 - Reference Pt.
Set Blue Carsonite Post 1' Southeast



Signed by: Craig W. McVean
Surveyor's Michigan License No.: 39088

Date: 11/24/2008