



**LAND CORNER RECORDATION CERTIFICATE**  
Filing Requirement of Act 74, Mich. PA 1970

For Corners In: <u>Missaukee</u> (County)	Located In	Corner Code #
1. Public Land Survey	T <u>23N</u> R <u>7W</u> <u>D9</u>	
	T _____ R _____	
2. Property Controlling in Section	S _____ T _____ R _____	
	S _____ T _____ R _____	
3. Miscellaneous Property in Section	S _____ T _____ R _____	
	S _____ T _____ R _____	
4. Lot No: _____	Recorded Plat: _____	
5. Private Claims: _____		

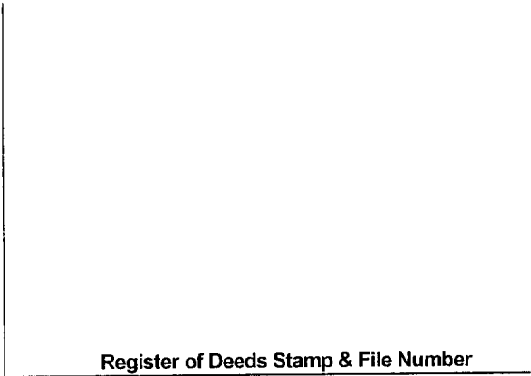

I, Craig W. McVean, in a field survey on Aug. 11, 2008 do hereby state that under requirements of PA 74, Michigan PA of 1970, the corner points mentioned in lines 1 and 2 above were in conformance with regulations and rules therefore as required in the current manual of survey instructions of the United States Department of the Interior, Bureau of Land Management or by a decree of a Court of Law and/or that the corner points mentioned in lines 3, 4 and 5 above were in conformance with the rules of the Michigan Board of Land Surveyors or by a Decree of a Court of Law; established, re-established, monumented, recovered, found as expressed below:

**NOTE: Not more than 2 corners, all in the same town and range, may be recorded on this certificate.**

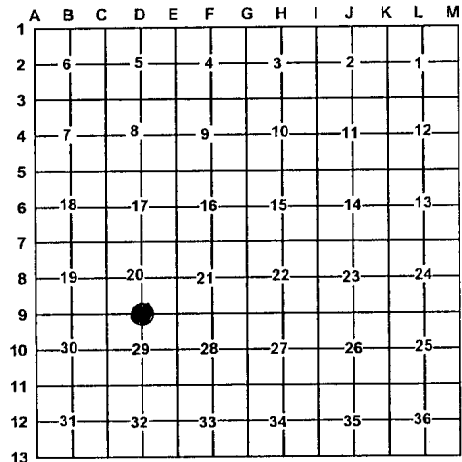

A. Description of original monument and accessories and/or subsequent restoration:

- D9 – **1853** – GLO – Set ¼ post – T. Whelphay  
 1) Hemlock 11" S42½°E 4 L.  
 2) Hemlock 9" N5°E 17 L.  
 - **1890** – CSR – FB #35, p. 50 & FB #14, p. 66 – Oak stake;  
 3) Blk. Oak 4" N45E° 106; 4) W. P. stub 20" S34°W 127.  
 Distance N. 20.01 & Distance E. 39.70.  
 - **2000** – LCRC #1430 – T. G. Hall – Fd. No evidence as to corner position. Set ½" rod and cap #14102 by single proportion. There is a N-S fence 150' west of position.  
 5) N15°W 1.04' – 3" Oak; 6) S30°E 16.86' – 5" Oak;  
 7) N75°W 7.02' - 6" White Pine; 8) S50°W 5.55' – 14" White Pine; South 75± Centerline 2-track
- **2005** – LCRC #2005 – 04954 – W. E. Sikkema – Fd. ½" iron & cap # 14102. No evidence of County Surveyor or GLO. Replace cap with Missaukee Co. Cap. No occupation at corner, centerline of E-W trail road is 75± South. 5) 3" W. Oak N15°W 1.04'; 6) 5" R. Oak S30°E 16.86'; 7) 6" W. Pine N75°W 7.02'; 8) 14" W. Pine S50°W 5.55'; 9) 4" R. Oak N68E° 16.95'

B. Description of corner evidence found and/or method applied in restoring or re-establishing corner:

- D9 – ¼ Corner Common to Sec. 20 & 29 – Found stps. of witnesses #3 & 4. Witnesses #1 & 2 are gone. Dug at corner position per witness but stake gone in dry sugar sand soil. Set 2 ½" Missaukee Co. Brass Cap on 5/8" x 34" rebar from witnesses as follows; S34°06'W 85.63' to set nail in centerline remains 20" White Pine Stub (#4); N44°52'E 70.94' to set nail in centerline 24" Oak stump (#3). Measured grid bearing distance of N0°18'53"W 1327.48' (1320.66'-CSR) to fd. 1890 wood stake at Cor. #12 & S88°01'43"E 2621.48' (2628.12'- GLO, 2620.20' – CSR) to 'E9'. Centerline of E-W Gravel Rd. is 40' S. Set Missaukee County Monument accepted as the best available evidence of the position of the original corner.
- Reference Pt. – Fd. 2 ½" Missaukee Co. Brass Cap on ½" rebar per LCRC #2005-04954 is N20°57'E 35.76' from 'D9'. This position was established by single proportion. Missaukee Co. Mon. on ½" rebar not utilized as 'D9' in this survey. Removed the 2 ½" Brass cap and leave ½" rebar in place.

C. Description of monument for corner and accessories established to perpetuate locating the position of the corner:

- D9 – Stamped 2 ½" Missaukee County Brass Cap on 5/8" x 34" rebar.  
 Add ring of stones. Set Cedar post 1' N.  
 N51°E 23.94' to set N & T in SE side 5" W. Pine  
 S75°E 15.56' to set N & T in S side 4" Oak  
 N64°W 33.13' to set N & T in NE side 8" W. Pine  
 N15°W 21.12' to set N & T in SW. side 11" R. Oak  
 N20°57'E 35.76' to Reference Pt. – ½" rebar



Signed by: Craig W. McVean  
 Surveyor's Michigan License No.: 39088

Date: 11/24/2008