



**LAND CORNER RECORDATION CERTIFICATE**  
 Filing Requirement of Act 74, Mich. PA 1970

For Corners In:				
Missaukee	Located In		Corner Code #	
(County)				
1. Public Land Survey	T	<u>23N</u>	R	<u>7W</u>
	T			<u>E4</u>
2. Property Controlling in Section	S		R	
	S		R	
3. Miscellaneous Property in Section	S		R	
	S		R	
4. Lot No: _____	Recorded Plat: _____			
5. Private Claims: _____				

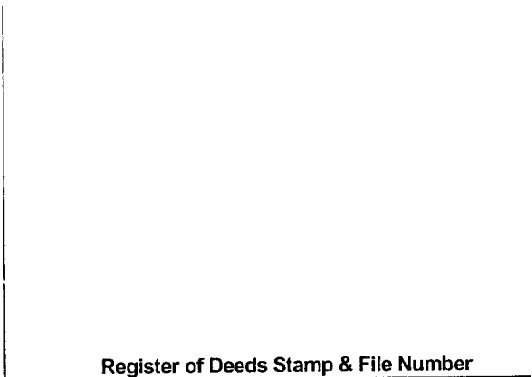

I, Craig W. McVean, in a field survey on August 21, 2008 do hereby state that under requirements of PA 74, Michigan PA of 1970, the corner points mentioned in lines 1 and 2 above were in conformance with regulations and rules therefore as required in the current manual of survey instructions of the United States Department of the Interior, Bureau of Land Management or by a decree of a Court of Law and/or that the corner points mentioned in lines 3, 4 and 5 above were in conformance with the rules of the Michigan Board of Land Surveyors or by a Decree of a Court of Law; established, re-established, monumented, recovered, found as expressed below:

**NOTE: Not more than 2 corners, all in the same town and range, may be recorded on this certificate.**

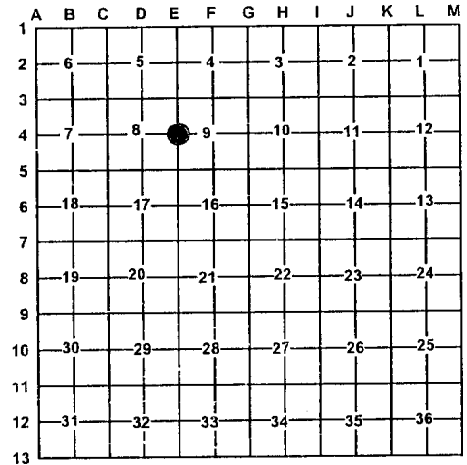

**A. Description of original monument and accessories and/or subsequent restoration:**

- E4 – 1853 – GLO – Set ¼ post - Thomas Whelpley**  
 1) Nor. Pine 13" S40°W 16 L.  
 2) Beech 12" N20¼°E 19 L.  
 - **1909 – CSR – FB# 35, p. 52 & FB #14, p. 70 - Red beech stake.**  
 3) W. Pine 28" N32°W 41 L.  
 4) W. Pine 28" N55½°W 95 L.  
 - **1914 – CSR – FB# 35, pg. 57 – E. A. Beuthien -**  
 ¼ S. Set by Cavanagh. Witnesses 3 & 4 repeated.  
 - **1981 – Record Survey – L. S-2, p. 504 - J. A. Ray - Fd. 3" Hub,**  
 set ½" iron. 3) N28°W 26.98' – 24" Pine stump; 5) N55°E 9.34' – 6" Poplar; 6) S45°E 20.98' – 5" Poplar; 7) S55°W 27.48' – 5" Poplar; 8) N5°W 44.75' Clump (5) 6" Maple
- **1997 – LCRC – File # 1128 – C. Kiiskila - found ½" x 24" rerod with J. Ray PS cap and one E. A. Beuthien pine stp. Wit. Old fence remains (B/wire @ some Cedar posts) to E-W & S. Center of Trail Roads NE'y & S'y is S45°E 63'±. Replace fd. ½" x 24" rerod with PS Cap with 1" x 36" galv. pipe with 4" Alum. DNR cap & set Blue Carsonite Post.**  
 9) 15" R. Oak N33°E 66.35' (Drove spike & tag SE side);  
 3) 24" W. Pine Stp. N33°W 26.98' (Drove 3/8" x 8" spike SE of Center); 10) 5" Maple S77°W 18.78' (drove sp. & tag N. side); 11) 5" Tw. R. Pine S55°E 80.03' (Drove Sp. & Tag NE side); 12) 5" R. Pine N80°E 127.85' (Drove Sp. & Tag N side).

**B. Description of corner evidence found and/or method applied in restoring or re-establishing corner:**

**E4 – ¼ Corner common to Sections 8 & 9 – Fd. 4" DNR Alum. Cap on 1" galv. iron pipe in agreement with witnesses #1 (fd. remains of stp.), #3 & Fd. 28" White Pine Stp. remains for witness #4 at 85 links (measured 56.5' to centerline) not 95 links. Witnesses #2, 7 & 8 are gone. Fd. fences remains E, W & S from corner. DNR Monument accepted as a careful and faithful perpetuation of the position of the original corner.**

**C. Description of monument for corner and accessories established to perpetuate locating the position of the corner:**

**E4 – 4" DNR Alum. Cap on 1" galv. iron pipe**  
 N53°E 9.24' to set N & T at old nail stain on SE side 14" Poplar (#5)  
 S50°E 20.99' to set N & T at fd.nail on SW side 14" Poplar (#6)  
 S55°E 79.90' to fd. N & T in NE side of twin 9" & 5" R. Pine (#11)  
 S77°W 18.75' to fd. N & T in N side 7" R. Maple (scribed 'XBT') (#10)  
 N33°W 26.99' to fd. cabin spike in 24" WPS (#3)  
 N35°E 66.33' to fd. N & T in SE side 16" Oak (#9)  
 N80°E 127.72' to fd. N & T in N side 10" R. Pine (#12)  
 Found Blue Carsonite Post 1.4' SE  
 Fd. 1" guard pipe 1.4' NE



Signed by: Craig W. McVean  
 Surveyor's Michigan License No.: 39088

Date: 11/24/2008