

LAND CORNER RECORDATION CERTIFICATE

Filing Requirement of Act 74, Mich. PA 1970

For Corners In: _____
 Missaukee _____
 (County)

		Located In		Corner Code #	
1. Public Land Survey	T	23N	R	7W	E5
	T	_____	R	_____	_____
2. Property Controlling in Section	S	T	R	_____	_____
	S	_____	T	_____	_____
3. Miscellaneous Property in Section	S	T	R	_____	_____
	S	_____	T	_____	_____


Register of Deeds Stamp & File Number

4. Lot No: _____ Recorded Plat: _____

5. Private Claims: _____

I, Craig W. McVean, in a field survey on August 21, 2008 do hereby state that under requirements of PA 74, Michigan PA of 1970, the corner points mentioned in lines 1 and 2 above were in conformance with regulations and rules therefore as required in the current manual of survey instructions of the United States Department of the Interior, Bureau of Land Management or by a decree of a Court of Law and/or that the corner points mentioned in lines 3, 4 and 5 above were in conformance with the rules of the Michigan Board of Land Surveyors or by a Decree of a Court of Law; established, re-established, monumented, recovered, found as expressed below:

NOTE: Not more than 2 corners, all in the same town and range, may be recorded on this certificate.

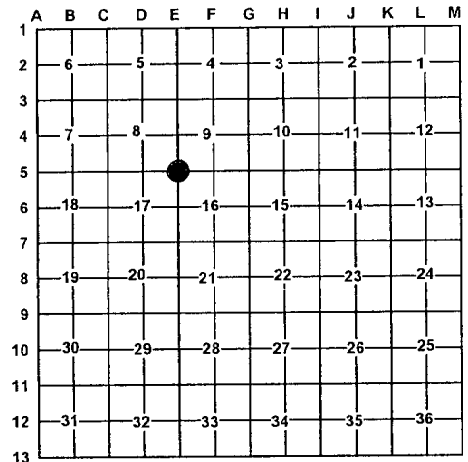

A. Description of original monument and accessories and/or subsequent restoration:

- | | |
|---|---|
| <p><u>E5</u> – 1853 – GLO – Set post - T. Whelpley</p> <ul style="list-style-type: none"> 1) Beech 11" N88°E 27 L 2) Beech 8" N68°W 23 L <p>- 1909 & 1914 – CSR – FB #35, p. 52 & 56 & FB #14, p. 70 – E. A. Beuthien – O.B. OK. NB</p> <ul style="list-style-type: none"> 3) WPS 12" S20°W 47½ 4) Cherry 4" N36½°W 26 <p>- 1962 – LCRC #469 – DNR Cor. Record – K. J. Ostling</p> <p>Found a 1" iron bolt with 1 ½" sq. head surrounded by rocks at corner, below surface of N. wheel track, as established by County Surveyor in 1909 survey in this area. Stump of 4" Cherry NBT in place and a site for SW White Pine stp. NBT. Falls in line with fence North.</p> | <ul style="list-style-type: none"> 6) 12" Twin Maple N16°E 56.5' 7) 16" R. Oak S68½°W 123.8' 8) Corner Fence Post North 21.5' <p>- 1997 – LCRC #1127 – Carl Kiiskila – Found bolt and witnesses per K.J. Ostling. Center of E-W Sand Rd. is 5' South. Center of 2-track North is 10'± West. Replaced bolt with 1"x 36" galvanized pipe with 4" aluminum DNR cap with 6"x10" concrete cylinder under cap. Drove Blue carsonite post with location tag North 20'.</p> <ul style="list-style-type: none"> 6) 15" Twin Maple N16°E 56.46' (Drove Nail & Tag SE Side) 7) 22" R. Oak S69°W 123.76' (Drove N & T) 9) 8" W. Pine N75°E 108.62' (Drove N & T S. side) 10) 12" R. Oak S55°E 58.10' (Drove N & T NE side) |
|---|---|

B. Description of corner evidence found and/or method applied in restoring or re-establishing corner:

E5 – Section corner common to Sections 8,9,16, & 17 - Found 4" DNR Alum. Cap in concrete – Down 0.8' – 5'± N of centerline E-W Trail Road. Remain of Fence to North. Witnesses #1, 2, 3, 4, 5, & 8 are gone.

DNR Monument accepted as a careful and faithful perpetuation of the position of the original corner.

C. Description of monument for corner and accessories established to perpetuate locating the position of the corner:

E5 – Stamped 4" DNR Alum. Cap concrete monument

- N16°E 56.42' to fd. N & T on SE side 16" Twin R. Maple (#6)
- N 75°E 108.58' to fd. N & T on SE side 10" W. Pine (#9)
- S 55°E 58.04' to fd. N & T on NE side 14" R. Oak (#10)
- S 69°W 123.58' to fd. N & T on N side 25" R. Oak (#7)
- North 20' to Blue Carsonite Post with loc. tag



Signed by: Craig W. McVean
 Surveyor's Michigan License No.: 39088

Date: 11/24/2008