

LAND CORNER RECORDATION CERTIFICATE

Filing Requirement of Act 74, Mich. PA 1970

For Corners In: Missaukee Located In _____ Corner Code # _____
(County)

1. Public Land Survey	T	<u>23N</u>	R	<u>7W</u>	<u>E7</u>
	T	_____	R	_____	_____
2. Property Controlling in Section	S	_____	T	_____	_____
	S	_____	T	_____	_____
3. Miscellaneous Property in Section	S	_____	T	_____	_____
	S	_____	T	_____	_____


4. Lot No: _____ Recorded Plat: _____

5. Private Claims: _____

I, Craig W. McVean, in a field survey on May 14, 2007 do hereby state that under requirements of PA 74, Michigan PA of 1970, the corner points mentioned in lines 1 and 2 above were in conformance with regulations and rules therefore as required in the current manual of survey instructions of the United States Department of the Interior, Bureau of Land Management or by a decree of a Court of Law and/or that the corner points mentioned in lines 3, 4 and 5 above were in conformance with the rules of the Michigan Board of Land Surveyors or by a Decree of a Court of Law; established, re-established, monumented, recovered, found as expressed below:

NOTE: Not more than 2 corners, all in the same town and range, may be recorded on this certificate.

Register of Deeds Stamp & File Number

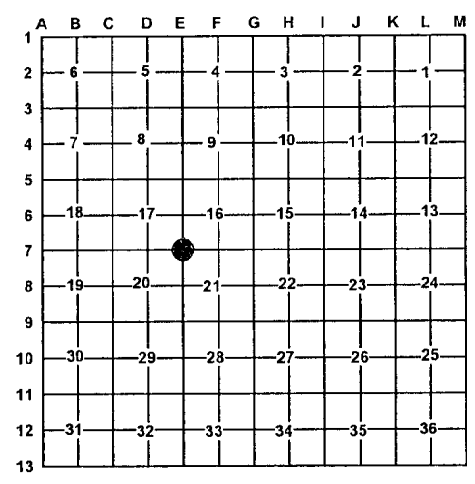

A. Description of original monument and accessories and/or subsequent restoration:


- | | |
|--|---|
| <p><u>E7</u> – 1853 – GLO – T. Whelpley – Set Post</p> <ul style="list-style-type: none"> 1) W. Pine 9 S35¼°E 6 L. 2) W. Pine 8 N47°W 11 L. 3) N. Pine 12 N80¼°E 33 L. <p>- 1892 & 1914 – CSR – E. A. Beuthein, FB # 35, p. 56;
Sec. 17 Petition Survey
OB OK – Cedar Fence is Corner</p> <ul style="list-style-type: none"> 4) P. Pine 10 N47°E 244 5) P. Pine 10 N45°W 257 <p>- 1895 – CSR – FB #14, p. 60</p> <ul style="list-style-type: none"> 6) Pitch Pine 9 S73½°E 60 7) Pitch Pine 10 N51°E 2.33 8) Pitch Pine 10 N25½°W 2.22 | <ul style="list-style-type: none"> - 1988 & 1991 – Recorded Survey L. S-3, p. 34 - R. L. Wetherell
½" capped iron set 9) 10" Jack Pine N70°E 19.41' 10) 8" Jack Pine S03°E 6.50' 11) 8" Jack Pine N45°W 26.86' <p>- 1988 – LCRC #770 – Marvin Myers – Found fence corner as called for by County Surveyor. Fd. ½" bar and cap #24624 at fence intersection as called for in County Surveyor Records.</p> <ul style="list-style-type: none"> 12) Nail NW face 6" J. Pine S20°W 10) Nail E face 6" J. Pine South 6.54' 11) Nail SW face 5" J. Pine N45°W 26.88' 9) Nail NW face 8" J. Pine N45°E 19.42' |
|--|---|

B. Description of corner evidence found and/or method applied in restoring or re-establishing corner:

E7 – Section corner common to Sections 16, 17, 20 & 21 - Found ½" capped iron #24624 at intersection of down fences E & S called for by County Surveyor, E. A. Beuthein. Witnesses #1 through #8 & #12 are gone. Witnesses #9, #10 & #11 fit ½" CIR but all dead. Removed ½" x 18" capped iron rod, dug down 1' and found old rotten wood fence corner bottom at East side of capped iron rod position. Accepted ½" x 18" capped iron rod #24624 as a careful and faithful perpetuation of the position of the original corner.

C. Description of monument for corner and accessories established to perpetuate locating the position of the corner:

E7 – Replaced ½" x 18" capped iron #24624 with stamped 4" Aluminum DNR cap on 1" x 36" galvanized iron pipe.
Add glass at base monument as memorial.
N64°E 60.31' to set nail and tag in Southeast side 8" White Pine
S31°E 65.29' to set nail and tag in East side 9" White Pine
S10°W 25.08' to set nail and tag in West side of 3" Cherry
S44°W 44.05' to set nail and tag in East side of 4" Jack Pine
Set Blue Carsonite Post 1' West

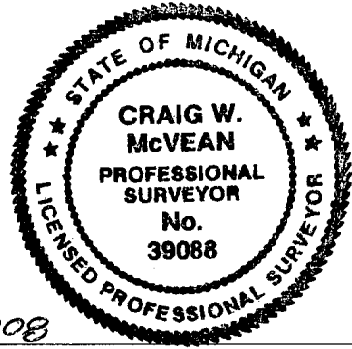

Signed by: Craig W. McVean
Surveyor's Michigan License No.: 39088

Date: 11/24/2008