

LAND CORNER RECORDATION CERTIFICATE

Filing Requirement of Act 74, Mich. PA 1970

For Corners In: Missaukee Located In _____ Corner Code # _____
(County)



1. Public Land Survey	T	23N	R	7W	B6
	T	_____	R	_____	_____
2. Property Controlling in Section	S	7	T	23N	R 7W 10
	S	_____	T	_____	R _____
3. Miscellaneous Property in Section	S	_____	T	_____	R _____
	S	_____	T	_____	R _____

4. Lot No: _____ Recorded Plat: _____

5. Private Claims: _____

I, Craig W. McVean, in a field survey on Dec. 15, 2009 do hereby state that under requirements of PA 74, Michigan PA of 1970, the corner points mentioned in lines 1 and 2 above were in conformance with regulations and rules therefore as required in the current manual of survey instructions of the United States Department of the Interior, Bureau of Land Management or by a decree of a Court of Law and/or that the corner points mentioned in lines 3, 4 and 5 above were in conformance with the rules of the Michigan Board of Land Surveyors or by a Decree of a Court of Law; established, re-established, monumented, recovered, found as expressed below:

NOTE: Not more than 2 corners, all in the same town and range, may be recorded on this certificate.

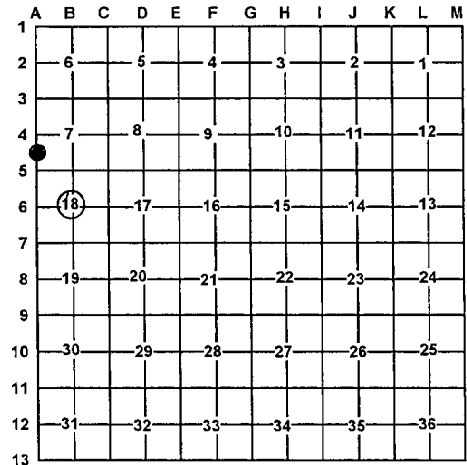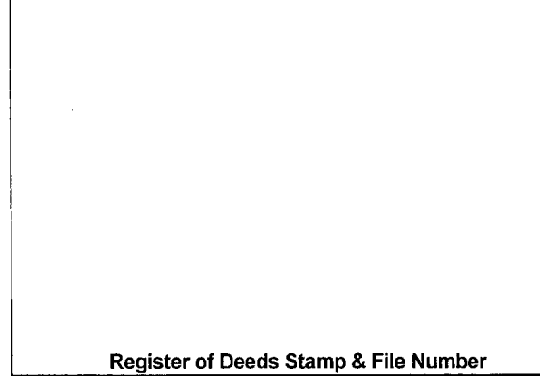

A. Description of original monument and accessories and/or subsequent restoration:

- B6 – 1981 – Recorded Survey L. S-2, p. 20 – John Milletics – Set 3" pipe
 - 1) North 32.07' to a 6" Pine; 2) S70°W 38.53' to a 8" Poplar
 - 3) S30°W 41.14' to a 4" Pine
- 2000 – Recorded Survey L. S-4, p. 150 – William E. Sikkema – Fd. 3" pipe
 - 4) N30°E 12.72' - 4" B. Spruce; 5) S28°E 24.95' - 4" B. Spruce
 - 6) S44°W 31.35' - 8" B. Spruce; 7) N78°W 22.23' - 10" poplar
- 2001 – Recorded Survey – Paul A. Trinklein – Fd. 3" pipe
 - 7) N87°W 22.29' - 6" Poplar; 5) S42°E 25.00' - 5" Balsam
 - 4) N18°E 12.73' - 5" Balsam; 6) S35°W 31.35' - 10" Balsam

- 10 - 1895 – CSR – FB #35, p. 49 & FB #14, p. 64
 - 1) WPS 40 N42°E 2
 - 2) Hem. 12 S37°E 10 1/2
- 1911 – CSR – FB #35, p. 76 – Cedar stake & stone
- 3) WPS 40 N42°E 6
- 1975 – Missaukee Industrial Park No. 1 – L. 2 of plats, p. 163 – 166: Concrete Monument placed.

B. Description of corner evidence found and/or method applied in restoring or re-establishing corner:

B6 – C 1/4 corner of Section 18 – Found 2 1/2" O.D. iron pipe up 1.0'. Witnesses #1 – found dead and fallen Fir; #2 – Found rotten and dying; & #3 – found Fir – OK. Witnesses #4 & 6 are in good condition. Line of wood post go N & E from pipe. 2 1/2" O.D. iron pipe is accepted as best available evidence of the position of the corner.

10 – S 1/16 Corner common to Sec. 7, T23N, R7W & Sec. 12, T23N, R8W – Fd. Broken plat monument. Cut off bottom of broken monument and reset 4" x 1.2' long concrete monument at correct position. 3'± West of centerline Old M-66 Rd. Bed. No evidence of Co. Sur. BT's or stake & stone.

C. Description of monument for corner and accessories established to perpetuate locating the position of the corner:

B6 – A 2 1/2" O.D. iron pipe, up 1.0'
 N18°E 12.69' to found nail in W. side 5" Balsam Fir (#4)
 S32°W 31.32' to found nail in NW side 9" Balsam Fir (#6)
 N57°W 32.10' to set nail & tag in NE side 5" Balsam Fir
 S85°E 18.11' to set nail & tag in N. side 5" Red Pine
 Set Blue Carsonite Post with location tag 1' West

10 – 4" x 1.2' long concrete monument with 1/2" iron.
 East 32.95' to Fd. 4" Conc. Mon and add Cedar post with loc. tag
 S86°E 69.28' to set N & T in S. side 3" W. Pine
 N35°E 107.90' to set N & T in NW side 38" W. Pine
 N20°E 105.69' to set N & T in SE side 4" W. Pine
 East 33.00' to set N & T in N. side set Cedar post

Signed by: Craig W. McVean
 Surveyor's Michigan License No.: 39088

Date: 6/1/2010

