

LAND CORNER RECORDATION CERTIFICATE

Filing Requirement of Act 74, Mich. PA 1970

For Corners In: Missaukee Located In _____ Corner Code # _____
(County)

1. Public Land Survey		T <u>23N</u>	R <u>7W</u>		D8
		T _____	R _____		_____
2. Property Controlling in Section	S <u>20</u>	T <u>23N</u>	R <u>7W</u>		5
	S _____	T _____	R _____		_____
3. Miscellaneous Property in Section	S _____	T _____	R _____		_____
	S _____	T _____	R _____		_____


4. Lot No: _____ Recorded Plat: _____

5. Private Claims: _____

I, Craig W. McVean, in a field survey on Aug. 21, 2008 do hereby state that under requirements of PA 74, Michigan PA of 1970, the corner points mentioned in lines 1 and 2 above were in conformance with regulations and rules therefore as required in the current manual of survey instructions of the United States Department of the Interior, Bureau of Land Management or by a decree of a Court of Law and/or that the corner points mentioned in lines 3, 4 and 5 above were in conformance with the rules of the Michigan Board of Land Surveyors or by a Decree of a Court of Law; established, re-established, monumented, recovered, found as expressed below:

NOTE: Not more than 2 corners, all in the same town and range, may be recorded on this certificate.

Register of Deeds Stamp & File Number

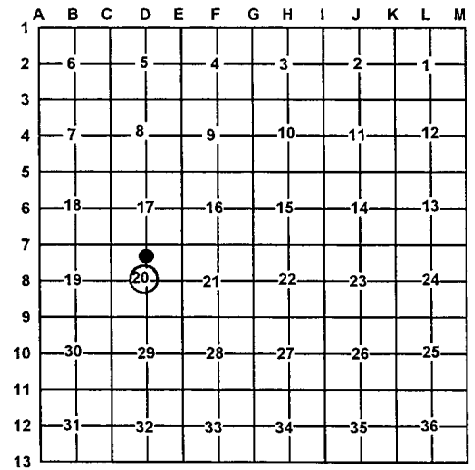

A. Description of original monument and accessories and/or subsequent restoration:

- | | |
|---|--|
| <p><u>D8</u> – 1890 – County Surveyor Record – E. A. Beuthein, BK 35, p. 50
 1) Pitch Pine 5" S54°E 53
 2) WPS 12" N51°W 20</p> <p>- 1890 – County Surveyor Record – Richardson BK 14, p. 66.
 Pine stake 4" x 4" x 4" high
 1) Pitch Pine 5" S54°E 53
 2) WPS 12" N53°W 20</p> | <p><u>5</u> – 1890 – County Surveyor Records – Richardson BK 14, p. 66 – Oak Stake
 1) WPS 10" S42°W 74
 2) WPS 26" N18°E 87</p> |
|---|--|

B. Description of corner evidence found and/or method applied in restoring or re-establishing corner:

- | | |
|--|---|
| <p><u>D8</u> – C ¼ corner of Section 20 – Searched area for evidence of county surveyor's stake and BTs. Dug holes off of possible BT's but no conclusive evidence of stake. Set stamped 2" Aluminum cap on 5/8" x 34" rebar at intersection of ¼ lines per standard BLM procedure. Centerline of E-W 2-track is 4' S.</p> | <p><u>5</u> – CN 1/16 Corner Section 20 – Searched area but found nothing Conclusive for BT's. Set stamped 2" Aluminum cap on 5/8" x 34" rebar per standard BLM procedure. West 1' to 2' to old downed barbed wire fence remains.</p> |
|--|---|

C. Description of monument for corner and accessories established to perpetuate locating the position of the corner:

- | | |
|--|--|
| <p><u>D8</u> – Stamped 2" Aluminum cap on 5/8" x 34" rebar
 N49°E 24.68' to set nail & tag in SE side 7" Red Oak
 N45°W 69.19' to set nail & tag in SW side twin 4" and 18" Red Maple scribed 'XBT'
 S27°W 65.15' to set nail & tag in E. side 26" Red Oak scribed 'XBT'
 S57°E 48.45' to set nail & tag in SW side 5" Red Maple scribed 'XBT'
 Set Blue Carsonite Post with location tag 1' North</p> | <p><u>5</u> – CN 1/16 Section 20 – Stamped 2" Aluminum cap on 5/8" x 34" rebar
 N02°E 21.22' to set nail & tag in W. side 6" White Oak
 N55°W 88.83' to set nail & tag in NE side twin 6" Red Maple
 S21°W 102.69' to set nail & tag in SE side 5" White Oak
 S25°E 22.79' to set nail & tag in E. side 4" White Oak
 Set Blue Carsonite Post with location tag 1' North</p> |
|--|--|

Signed by: Craig W. McVean
 Surveyor's Michigan License No.: 39088

Date: 6/1/2010

