

# LAND CORNER RECORDATION CERTIFICATE

Filing Requirement of Act 74, Mich. PA 1970



For Corners In: <u>Missaukee</u> (County)	Located In	Corner Code #
1. Public Land Survey	T _____ R _____	_____
	T _____ R _____	_____
2. Property Controlling in Section	S <u>8</u> T <u>23N</u> R <u>7W</u>	<u>7</u>
	S <u>8</u> T <u>23N</u> R <u>7W</u>	<u>SS1/64</u>
3. Miscellaneous Property in Section	S _____ T _____ R _____	_____
	S _____ T _____ R _____	_____

4. Lot No: \_\_\_\_\_ Recorded Plat: \_\_\_\_\_

5. Private Claims: \_\_\_\_\_

I, Craig W. McVean, in a field survey on Jan. 19, 2010 do hereby state that under requirements of PA 74, Michigan PA of 1970, the corner points mentioned in lines 1 and 2 above were in conformance with regulations and rules therefore as required in the current manual of survey instructions of the United States Department of the Interior, Bureau of Land Management or by a decree of a Court of Law and/or that the corner points mentioned in lines 3, 4 and 5 above were in conformance with the rules of the Michigan Board of Land Surveyors or by a Decree of a Court of Law; established, re-established, monumented, recovered, found as expressed below:

**NOTE: Not more than 2 corners, all in the same town and range, may be recorded on this certificate.**

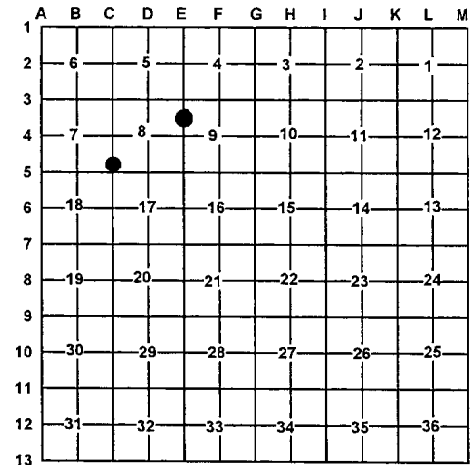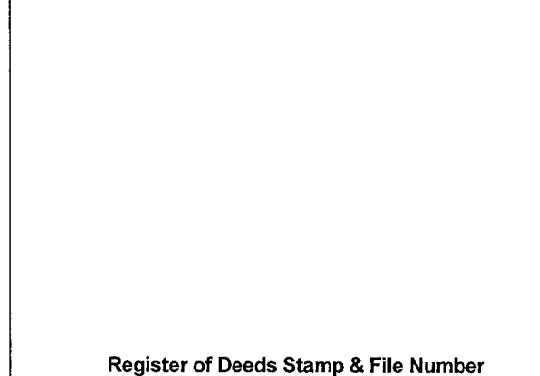

A. Description of original monument and accessories and/or subsequent restoration:

- Z - 1914 - CSR - FB #35, p. 57 - E. A. Beuthien SS 1/64 - None
- 1) WPS 18" N40°W 36
- 1981 - Rec. Survey & Field Notes - L. S-2, p. 504 - J. A. Ray - Replaced fd. wood hub with 1/2" iron and cap.



B. Description of corner evidence found and/or method applied in restoring or re-establishing corner:

- Z - N 1/16 Corner common to Sec. 8 & 9 - Fd. 1/2" x 24" smooth iron bar with Cap #25869 per J. A. Ray. Fence remains N & E. Measured N41°W 23.9' to Fd. notch in 18" W. Pine Stp. being witness #1. 1/2" CIR accepted as the best available evidence of the position of the corner.
- SS 1/64 - Corner common to Sec. 7 & 8 being the SW corner of the N 1/2 of the SW 1/4 of the SW 1/4 of Sec. 8 - Set 2" Alum. Cap on 5/8" x 34" rebar per standard BLM procedure. Old down N-S fence remains are 43' East.

C. Description of monument for corner and accessories established to perpetuate locating the position of the corner:

- Z - Replaced 1/2" x 24" CIR #25869 with stamped 2" Alum. Cap on 5/8" x 34" iron rebar. Set Blue Carsonite Post with loc. tag 1' West.
  - N41°W 23.74' to set N & T in SE side 18" WPS (#1)
  - S77°E 28.16' to set N & T in S. side Tw. 8" & 18" S. Maple
  - S21°W 14.09' to set N & T in E. side 10" & 8" R. Maple
  - S61°W 29.96' to set N & T in NW side 10" S. Maple
- SS 1/64 - Stamped 2" Alum. Cap on 5/8" x 34" rebar
  - Set Blue Carsonite Post with loc. tag 1' NW
  - N10°E 12.29' to set N & T in W. side 7" Fir
  - N74°E 18.14' to set N & T in S. side 6" Fir
  - S8°W 8.98' to set N & T in E. side 8" Fir
  - S54°W 24.40' to set N & T in SE side 13" Cedar

Signed by: Craig W. McVean  
 Surveyor's Michigan License No.: 39088

Date: 6/11/2010