

LAND CORNER RECORDATION CERTIFICATE

Filing Requirement of Act 74, Mich. PA 1970

For Corners In: Missaukee Located In _____ Corner Code # _____
(County)

1. Public Land Survey T _____ R _____
T _____ R _____

2. Property Controlling in Section S 19 T 23N R 7W 5
S 19 T 23N R 7W 6


3. Miscellaneous Property in Section S _____ T _____ R _____
S _____ T _____ R _____

4. Lot No: _____ Recorded Plat: _____

5. Private Claims: _____

I, Craig W. McVean, in a field survey on Oct. 8, 2007 do hereby state that under requirements of PA 74, Michigan PA of 1970, the corner points mentioned in lines 1 and 2 above were in conformance with regulations and rules therefore as required in the current manual of survey instructions of the United States Department of the Interior, Bureau of Land Management or by a decree of a Court of Law and/or that the corner points mentioned in lines 3, 4 and 5 above were in conformance with the rules of the Michigan Board of Land Surveyors or by a Decree of a Court of Law; established, re-established, monumented, recovered, found as expressed below:

NOTE: Not more than 2 corners, all in the same town and range, may be recorded on this certificate.

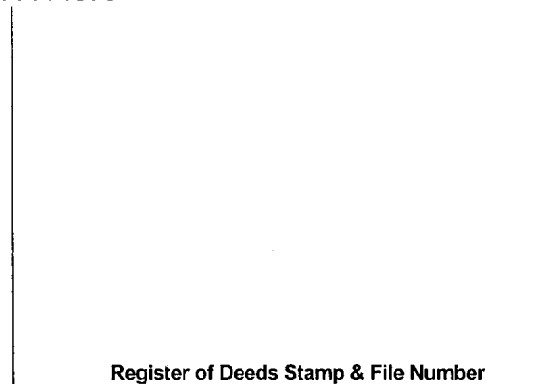

	A	B	C	D	E	F	G	H	I	J	K	L	M
1													
2	6			5		4		3		2		1	
3													
4	7		8			9		10		11		12	
5													
6	18			17		16		15		14		13	
7													
8	19			20		21		22		23		24	
9													
10	30			29		28		27		26		25	
11													
12	31			32		33		34		35		36	
13													

A. Description of original monument and accessories and/or subsequent restoration:

5 – **1892 & 1914** – CSR – FB #35, p. 55 – E. A. Beuthien –
Petition Survey Sec. 19 –
- **1974** – Rec. Survey L. S-1, p. 177 – J. L. Wilcox – iron set

6 – **1892 & 1914** – CSR – FB #35, p. 55 – E. A. Beuthien –
Petition Survey Sec. 19 –
1) YPS S46°W 31
2) YPS S20°E 117

B. Description of corner evidence found and/or method applied in restoring or re-establishing corner:

5 – CN 1/16 Cor. Sec. 19 – Fd. 1/2" x 24" long capped rebar #14102. Falls at remains of fence corner of fence remains S & W. Witness #1 is gone. 1/2" CIR accepted as the best available evidence of the position of the corner.

6 – NE 1/16 Cor. Sec. 19 – No evidence of Beuthien's BT's. Falls in old dump area. Set 2" Alum. Cap on 5/8" x 34" rebar per Standard BLM procedure.

C. Description of monument for corner and accessories established to perpetuate locating the position of the corner:

5 – Replaced 1/2" x 24" capped rebar #14102 with stamped 2" Alum. Cap on 5/8" x 34" rebar
S18°E 3.97' to set nail & tag in E side 6" R. Maple in clp. – 6
N73°E 70.66' to set nail & tag in S side 12" Oak
N21°W 62.05' to set nail & tag in E side 12" Oak
N65°W 3.88' to set nail & tag in NE side 6" W. Oak
NNW 1.4' to fd. steel fence post
Set Blue Carsonite Post with loc. tag 1' North

6 – Stamped 2" Alum. Cap on 5/8" x 34" rebar.
Set Blue Carsonite Post with loc. tag 1' NE
S20°E 53.09' to set nail & tag in W side 20" Oak
N20°W 67.28' to set nail & tag in W side 18" Oak
N79°E 85.87' to set nail & tag in N side Tw. 10" Ash
S35°W 97.50' to set nail & tag in SE side 9" R. Maple

Signed by: Craig W. McVean
Surveyor's Michigan License No.: 39088

Date: 6/1/2010

