

LAND CORNER RECORDATION CERTIFICATE


Filing Requirement of Act 74, Mich. PA 1970

For Corners In: <u>Missaukee</u> (County)	Located In	Corner Code #	
1. Public Land Survey	T _____ R _____		
	T _____ R _____		
2. Property Controlling in Section	S <u>20</u> T <u>23N</u> R <u>7W</u>		<u>1</u>
	S <u>20</u> T <u>23N</u> R <u>7W</u>		<u>3</u>
3. Miscellaneous Property in Section	S _____ T _____ R _____		
	S _____ T _____ R _____		
4. Lot No: _____	Recorded Plat: _____		
5. Private Claims: _____			

Register of Deeds Stamp & File Number

I, Craig W. McVean, in a field survey on Aug. 8, 2007 do hereby state that under requirements of PA 74, Michigan PA of 1970, the corner points mentioned in lines 1 and 2 above were in conformance with regulations and rules therefore as required in the current manual of survey instructions of the United States Department of the Interior, Bureau of Land Management or by a decree of a Court of Law and/or that the corner points mentioned in lines 3, 4 and 5 above were in conformance with the rules of the Michigan Board of Land Surveyors or by a Decree of a Court of Law; established, re-established, monumented, recovered, found as expressed below:

NOTE: Not more than 2 corners, all in the same town and range, may be recorded on this certificate.

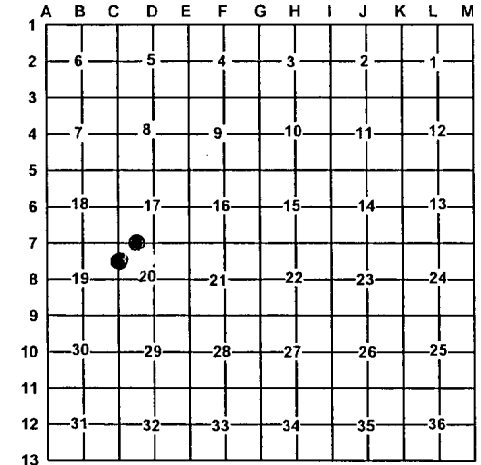

A. Description of original monument and accessories and/or subsequent restoration:

- | | |
|--|--|
| <u>1</u> – 1892 & 1914 – CSR – FB #35, p. 56 – E. A. Beuthien – Apple 3" N11¼°E 41 | <u>3</u> – 1892 & 1914 – CSR – FB. #35, p. 55 – E. A. Beuthien – WPS 30 S33°W 69 |
|--|--|

B. Description of corner evidence found and/or method applied in restoring or re-establishing corner:

- | | |
|---|---|
| <u>1</u> – W 1/16 Cor. common to Sec. 17 & 20 – Could not find any conclusive evidence of Beuthien post or BT. Set 2" Alum. Cap on 5/8" x 34" rebar per Standard BLM procedure. Falls in remains of N-S fence & field line. Centerline of E-W 2-track is 68'± S. Centerline 2-track drive Northerly is 17' W. | <u>3</u> – N 1/16 Corner common to Sec. 19 & 20 – Could not find any conclusive evidence of Beuthien post or BT. Set 2" Alum. Cap on 5/8" x 34" rebar per Standard BLM procedure. |
|---|---|

C. Description of monument for corner and accessories established to perpetuate locating the position of the corner:

- | | |
|---|---|
| <u>1</u> - Stamped 2" Alum. Cap on 5/8" x 34" rebar
N52°W 32.88' to set nail & tag in NE side 9" J. Pine
S77°W 27.56' to set nail and tag in N side 10" Cherry
S19°W 61.06' to set nail & tag in W side 4" Oak
S37°E 35.23' to set nail & tag in W side 3" Cherry
Set Blue Carsonite Post with loc. tag 1' S | <u>3</u> – Stamped 2" Alum. Cap on 5/8" x 34" rebar
Set Blue Carsonite Post 1' NW
N30°W 38.38' to set nail & tag in SW side 14" R. Pine
N44°E 67.32' to set nail & tag in NW side 10" R. Pine
S58°E 64.25' to set nail & tag in SW side 11" R. Pine
S46°W 43.13' to set nail and tag in SE side 9" Oak |
|---|---|

Signed by: Craig W. McVean
 Surveyor's Michigan License No.: 39088

Date: 6/1/2010

