LAND CORNER RECORDATION CERTIFICATE

Filing Requirement of Act 74, Mich. P.A. 1970

For corners in
MISSAUKEE
(County)

	Located In:	Corner Code ##
1. Public Land Survey	T 23N R 8W	K-9
	T ___ R ___	K-10
	T ___ R ___	
	T ___ R ___	
2. Property Controlling	S ___ T ___ R ___	
in Section	S ___ T ___ R ___	
3. Miscellaneous	S ___ T ___ R ___	
Property in Sec.	S ___ T ___ R ___	

Register of Deeds Stamp & File Number

4. Lot No. _____ , Recorded Plat _____
5. Private Claims _____

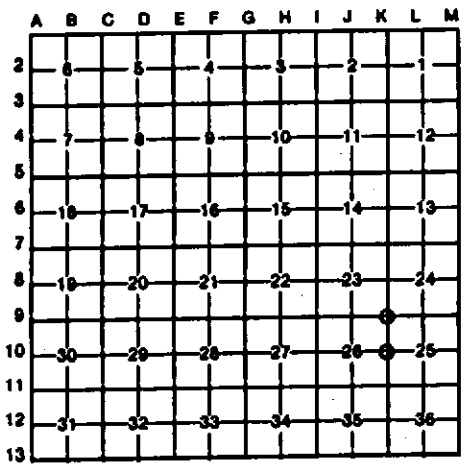

I, CARL F. ROSER, in a field survey on 01/28, 19 88, do hereby certify that under requirements of P.A. 74, Michigan P.A. of 1970, the corner points mentioned in lines 1 and 2 above were in conformance with regulations and rules therefore as required in the current manual of survey instructions of the United States Department of the Interior, Bureau of Land Management or by a decree of a Court of Law and/or that the corner points mentioned in lines 3, 4 and 5 above were in conformance with the rules of the Michigan Board of Land Surveyors or by a Decree of a Court of Law; established, re-established, monumented, re-monumented, recovered, found as expressed below:

NOTE: Not more than 4 corners, all in the same town and range, may be recorded on this certificate.

A. Description of original monument and accessories and/or subsequent restoration:

K-9

K-10

B. Description of corner evidence found and/or method applied in restoring or reestablishing corner:

K-9

FD 3/4" PIPE ALONG WEST SIDE OF 1'x 2' STONE; AS RECOVERED BY MSHD IN 1966. COR FALLS IN N-S FN; LOOKS LIKE N END OF FN IS 8' N(END BRACE POLE).

K-10

FD 4" ROUND CONC MON, WITH OLDER TYPE "STATE OF MICH" BRONZE CAP. FITS SP POSITION BETWEEN FD NW&SW OF S-25. MSHD (1966) SUR NOTES SAY N 1/4 COR S-25 SEARCHED FOR, NOTHING FD. SUR CREW WORKED OUT OF MISS CO RD CONN GARAGE(IN SE 1/4 S-25) ON M-66 SUR, & THIS SURVEYOR THINKS IT LIKELY THAT RD CONN SET MON SP FROM HARLAN PAGE'S TRV IN VIC OF N 1/4 S-25.

C. Description of monument for corner and accessories established to perpetuate locating the position of the corner:

K-9

FD 3/4" PIPE; REPLACED W/DNR MON.

K-10

FD 4" CONC MON W/BRONZE CAP; ADDED CED POST W/LOC TAG.

CTR RR GRADE(NW-SE) SOUTH 72'

* 22" TWN W OAK	N15 W	20.49	* 12" R OAK	N30 W	34.83
* 9" MAP(CLUMP)	N55 E	46.00	* 8" TWN MAP	EAST	27.37
* 28" W OAK	S70 W	14.29	* 16" W OAK	S45 W	43.64
4" W OAK	S55 E	25.91	4" MAPLE	S35 E	15.13

* = MSHD WITS

* = EXIST WIT TREES

STATE OF MICHIGAN
CARL F. ROSER
LAND SURVEYOR
No. 12028
REGISTERED LAND SURVEYOR

Signed by Carl F. Roser 2-01-88 Date _____

Surveyor's Michigan License No. 12028

FORM APPROVED BY MICHIGAN STATE BOARD OF LAND SURVEYORS, JAN. 28, 1971
REVISED MAY 14, 1975
REVISED JAN., 1983

SEE SKETCH ON BACK