


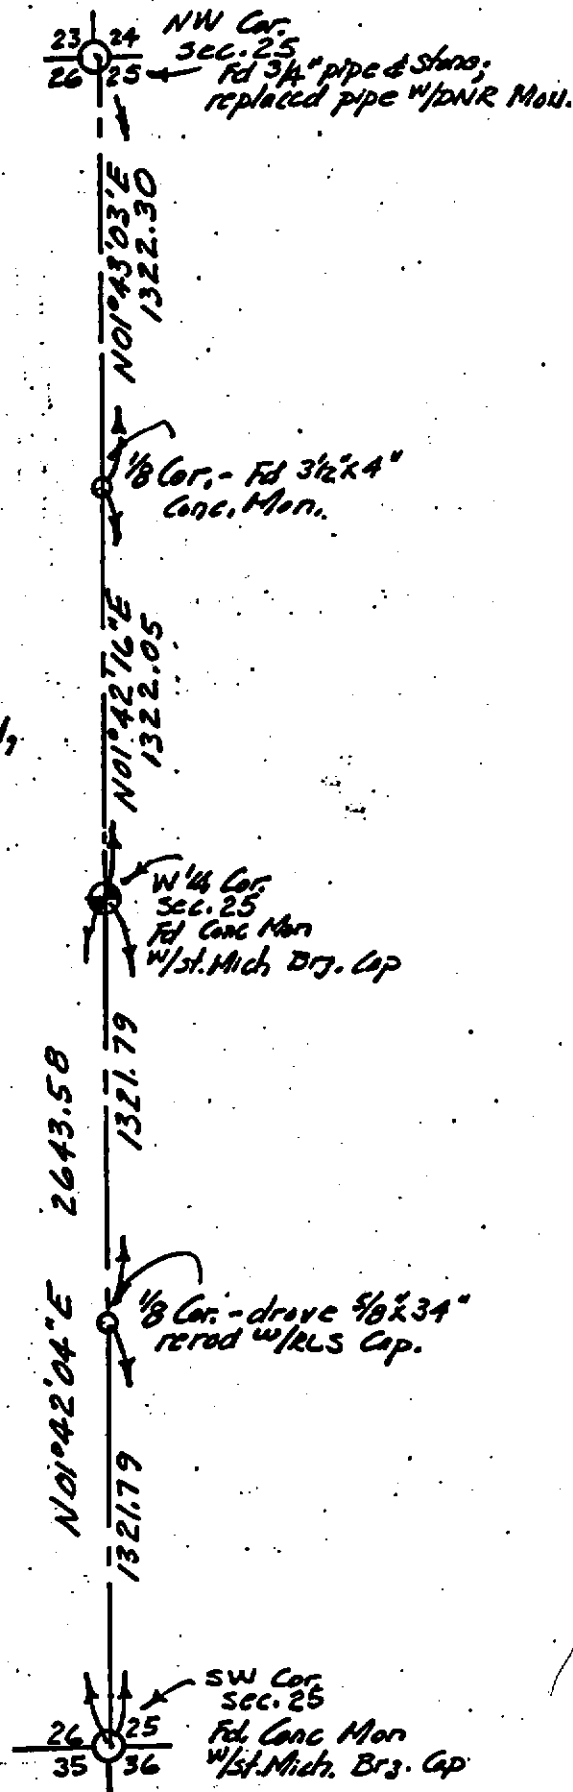

SKETCH OF SURVEY
 OF SEC. LINE COMM. TO
 SEC'S 25 & 26, T23N-R8W,
 Missaukee Co., Mich.
 Mich. Dept. of Natural
 Resources.



C. ROSE
 02-01-88