

JAN 27 1999

SECTION

REFER 324 PAGE 1287

LAND CORNER RECORDATION CERTIFICATE
Filing Requirement of Act 74, Mich. P.A. 1970

1307

For corners in
Missaukee
(County)

Located In: Corner Code #

1. Public Land Survey	T	23N	R	8W	F-13
	T		R		
	T		R		
	T		R		
2. Property Controlling in Section	S		T	R	
	S		T	R	
3. Miscellaneous Property in Sec.	S		T	R	
	S		T	R	

MISSAUKEE COUNTY MICHIGAN

RECORDED DEC 28 1998 1:00 P.M.

Carolyn Florie
REGISTER

Register of Deeds Stamp & File Number

4. Lot No. _____, Recorded Plat _____
5. Private Claims _____

I, Phillip D. Case, in a field survey on August 18, 1998 do hereby state that under requirements of P.A. 74, Michigan P.A. of 1970, the corner points mentioned in lines 1 and 2 above were in conformance with regulations and rules therefore as required in the current manual of survey instructions of the United States Department of the Interior, Bureau of Land Management or by a decree of a Court of Law and/or that the corner points mentioned in lines 3, 4 and 5 above were in conformance with the rules of the Michigan Board of Land Surveyors or by a Decree of a Court of Law; established, re-established, monumented, recovered, found as expressed below:

NOTE: Not more than 2 corners, all in the same town and range, may be recorded on this certificate.

A	B	C	D	E	F	G	H	I	J	K	L	M
1												
2	6	5	4	3	2	1						
3												
4	7	8	9	10	11	12						
5												
6	18	17	16	15	14	13						
7												
8	19	20	21	22	23	24						
9												
10	30	29	28	27	26	25						
11												
12	31	32	33	34	35	36						
13												

A. Description of original monument and accessories and/or subsequent restoration:

F-13, One-quarter corner common to Section 33, T23N, R8W and Section 4, T22N, R8W: Post set in original government survey by Deputy Surveyor Brink in May of 1838: Corner witnessed by:
N51°E - 10" White Pine - 1.06 chains N06°W - 14" White Pine - 1.08 Chains
Missaukee County Surveyors notes of April 4, 1894 for Section 33. Call ¼ post and meander post as one and witnessed by:
S05°W - 18" Dead Yellow Pine - 60 links
N84°E - Yellow Pine Stump - 54 links
Plat of Indian Hills recorded in 1956 makes ties to corner falling within Lot 5.

B. Description of corner evidence found and/or method applied in restoring or reestablishing corner:

F-13, Set from retracement of the Plat of Indian Hills.

Peer Group Reviewed and Approved

Date: 10-26-98


J. Dean Geers
J. Dean Geers, Missaukee Co. Representative

Accepted as the best available evidence of the position of the original corner.

C. Description of monument for corner and accessories established to perpetuate locating the position of the corner:

F-13
Set ½" Iron Rod with Stamped Missaukee County Brass Cap

- S42°E - 12" Oak - 21.72'
- N31°W - 12" Twin W. Pine - 40.70'
- S89°W - 20" Twin Oak - 35.11'
- S18°W - 20" Oak - 52.88'

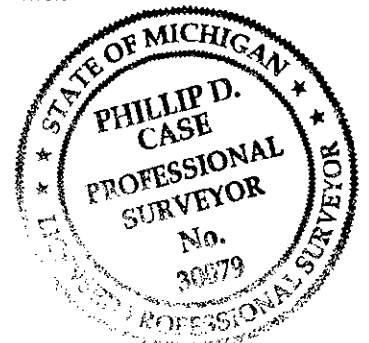

Signed by *Phillip D. Case*
Surveyor's Michigan License No. 30079

Date NOVEMBER 19, 1998