

JAN 27 1999

SECTION

LIBER 324 PAGE 1290

LAND CORNER RECORDATION CERTIFICATE
Filing Requirement of Act 74, Mich. P.A. 1970

1310

For corners in

Table with columns: Missaukee (County), Located In, Corner Code #. Rows include Public Land Survey, Property Controlling in Section, and Miscellaneous Property in Sec.

MISSAUKEE COUNTY MICHIGAN

RECORDED DEC 28 1998 4:00 P.M.

Signature of Carolyn Flare, REGISTER

Register of Deeds Stamp & File Number

4. Lot No. , Recorded Plat
5. Private Claims

I, Phillip D. Case, in a field survey on August 19, 1998 do hereby state that under requirements of P.A. 74, Michigan P.A. of 1970, the corner points mentioned in lines 1 and 2 above were in conformance with regulations and rules therefore as required in the current manual of survey instructions of the United States Department of the Interior, Bureau of Land Management or by a decree of a Court of Law and /or that the corner points mentioned in lines 3, 4 and 5 above were in conformance with the rules of the Michigan Board of Land Surveyors or by a Decree of a Court of Law; established, re-established, monumented, recovered, found as expressed below:

Grid table with columns A-M and rows 1-13. A dot is marked at row 13, column J.

NOTE: Not more than 2 corners, all in the same town and range, may be recorded on this certificate.

A. Description of original monument and accessories and/or subsequent restoration:

I-13, Corner common to Sections 34 and 35, T23N-R8W and Sections 2 and 3, T22N-R8W; post set in pond in original government survey by Deputy Surveyor Brink in May of 1838; corner witnessed by:

S82 1/2°W - 14" White Pine - 1.90 chains and N56°W - 12" Yellow Pine - 3.52 chains

B. Description of corner evidence found and/or method applied in restoring or reestablishing corner:

I-13. Found 4"x4" pointed cedar post with squared off end. Corner falls in a marsh and fits a position prorated to the government distances along the township line. Set 1 1/4" I.D. Pipe with a Missaukee County Brass Cap at the point of the found stake.

Peer Group Reviewed and Approved

Date: 10-21-98


J. Dean Geers, Missaukee Co. Representative

Replaced cedar post with Missaukee County monument and is accepted as a careful and faithful perpetuation of the position of the original corner.

C. Description of monument for corner and accessories established to perpetuate locating the position of the corner:

I-13
Set 1 1/4" I.D. Pipe with Missaukee County Brass Cap

- S50°W - 26" White Pine - 25.98'
N82°W - 18" White Pine - 43.68'
South - 30" White Pine - 77.06'
S83°E - 16" Oak - 232.40'

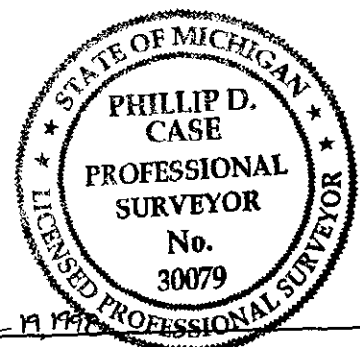

Signed by Phillip D. Case, 30079
Surveyor's Michigan License No.

Date November 17 1998