


LAND CORNER RECORDATION CERTIFICATE

Filing Requirement of Act 74, Mich. PA 1970

For Corners In: <u>Missaukee</u> (County)	Located In	Corner Code #	
1. Public Land Survey	T <u>23N</u> R <u>8W</u>	<u>K7</u>	
	T _____ R _____	_____	_____
2. Property Controlling in Section	S _____ T _____ R _____	_____	_____
	S _____ T _____ R _____	_____	_____
3. Miscellaneous Property in Section	S _____ T _____ R _____	_____	_____
	S _____ T _____ R _____	_____	_____
4. Lot No: _____	Recorded Plat: _____		
5. Private Claims: _____			

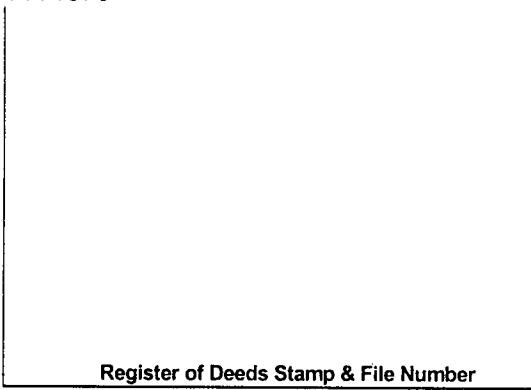

I, Craig W. McVean, in a field survey on June 3, 2004 do hereby state that under requirements of PA 74, Michigan PA of 1970, the corner points mentioned in lines 1 and 2 above were in conformance with regulations and rules therefore as required in the current manual of survey instructions of the United States Department of the Interior, Bureau of Land Management or by a decree of a Court of Law and/or that the corner points mentioned in lines 3, 4 and 5 above were in conformance with the rules of the Michigan Board of Land Surveyors or by a Decree of a Court of Law; established, re-established, monumented, recovered, found as expressed below:

NOTE: Not more than 2 corners, all in the same town and range, may be recorded on this certificate.

	A	B	C	D	E	F	G	H	I	J	K	L	M
1													
2	6		5		4		3		2		1		
3													
4	7		8		9		10		11		12		
5													
6	18		17		16		15		14		13		
7													
8	19		20		21		22		23		24		
9													
10	30		29		28		27		26		25		
11													
12	31		32		33		34		35		36		
13													

A. Description of original monument and accessories and/or subsequent restoration:

- K7-GLO - Set post - T. Whepley - 1852
 W. Pine 20" N78 1/4° E 7 L.
 Beech 8" S 13 1/2° E 8 L.
 W. Oak 12" S75 1/4°W 41 L.
- Teed- FB #79, P. 4 & 5 - 1887
 2 Wit. OK. Set stake.
- Teed - FB #79, P. 28-29 - Sec. 13 Survey - 1889
 Post
- Teed - FB #79, P. 62-63 - Sec. 24 Survey - 1894
- Teed - FB #79, P. 68-69 - Sec. 14 Survey - 1894 ±
- M-42 Alignment Notes - 1934 - MDOT
 "Nothing in sight of US Witnesses. We dug according to fence and fire lines. We uncovered an old monument which consists of a 4" x 4" x 27" Cedar stake, practically plumb in place solid, heart of stake sound, stake stands in a naturally formed socket of fine fibrous roots which feeds on the surface material of the cedar stake. Soil is lean sand. We put in a 3/4" x 18" galv. iron pipe stones and brick monument. Below center of top of stake. Top of iron pipe is down 2.2'. Top of cedar stake is down 0.4'. Monument stands under SE shoulder of an old logging railroad grade. Pit extends from this mon. N 1', S 2' & W 7' " 0°04' - 73.6' - 12" B. Oak; ESE 4.5' Pine snag roots of possible GLO wit.; WPS 24' - 312° 05' 30.7';
 270°00 - 37.75' - Fence Cor. N & W;
 296° - 30' - 12" W. Oak 164.5';
 305° 26' - 10" W. Oak 167.9'
- LCRC #263 - MDOT Wit. Card - H.J. Page - 1967. Fd 3/8" x 18" angle iron in E. wheel track of trail - N2°W 75.75 - 31" Oak; W 40' Fence post; S40°W 35.57' - 30" Tri. Oak
- LCRC #200 & Rec. Sur. - L. S-1, P. 273 - J.L. Fletcher - 1977 - Fd. 3/8" x 18" angle iron; Fd. nail in 24" R. Oak N2°W 74.73'; set nail in 8" Wild Cherry N76°W 38.86'; set nail in 13" R. Oak S87°E 79.88'.
- LCRC - L. 4, p. 1485 - C. W. McVean - 2002 - Fd. 2" x 2" x 3/4" wide x 18" long 'L' iron in CL winding N-S 2-track per LCRC's. Replaced 2" x 2" x 3/8 wide 'L' iron w/ 4" DNR Alum. Cap on 1" x 2.7' long galv. iron pipe w/ 4" x 1' long PVC 2/ conc. around cap - down 0.7'
 North 75.89' to set N & T in W side 40" Oak (HJP, JLF)
 S41°W 35.47' to set N & T in NW side Tri. 20" R. Maple (HJP)
 S88°E 79.94' to set N & T in S side 24" Oak scribed 'XBT' - (JLF)
 N48°E 50.31' to set N & T in NW side 4" W. Pine
 S59°E 76.07' to set N & T in SW side 15" R. Pine scribed 'XBT'
 N32°E 8.74' to set N & T in SE side 17" Oak
 E. 20' to set Blue Carsonite Post w/ Loc. tag


B. Description of corner evidence found and/or method applied in restoring or re-establishing corner:

K7 - Sec. corner common to Sec. 13, 14, 23 & 24 - Fd. nest of stones and bricks and below a 3/4" iron pipe - 2.2' below surface - of centerline of N-S 2-track per 1934 MDOT notes. Fits one living MDOT BT's and remains of 3 others. Fits Teed's distances N, S & E closely. CL. of old NE-SW railroad grade is 7'± NW. 3/4" iron pipe accepted as the best available evidence of the position of the original corner.

Reference Pt. - Fd. 4" DNR Alum. Cap mon. per LCRC L. 4, p. 1485 is S43°57'E 1.87' from 'K7'. This position based on LCRC# 263, & #200 and Rec. Survey S-1, p. 273, but cannot be accepted based on 1934 MDOT notes which have recently come to light. Thus 4" DNR Alum. not utilized as 'K7' in this survey. Removed this 4" DNR Mon.

C. Description of monument for corner and accessories established to perpetuate locating the position of the corner:

- K7 - Raised 3/4" Iron pipe w/ 2 1/2" DNR Brass cap on 5/8" x 17" Iron rebar w/ concrete around cap - Down 1'
 N4°E 74.51' to found N & T in W side 42" B. Oak (MDOT)
 N50°E 8.62' to found N & T in SE side 16" R. Oak
 N 52°E 50.34' to found N & T in N side 4" W. Pine
 S87°E 81.31' to found N & T in S side 25" R. Oak, scribed 'XBT'
 S58°E 77.84' to found N & T in SE side 16" R. Pine scribed 'XBT'
 S45°W 35.52' to found N & T in NW side tri 20" R. Maple
 N 55°W 164.5'± found Oak stp. (MDOT)
 N60°W 168.7'± found oak stp. (MDOT)
 Set blue carsonite post w/ loc tag 20' E - Reset
 S43° 57' E 1.87' to Ref. Pt. - Removed DNR Mon.

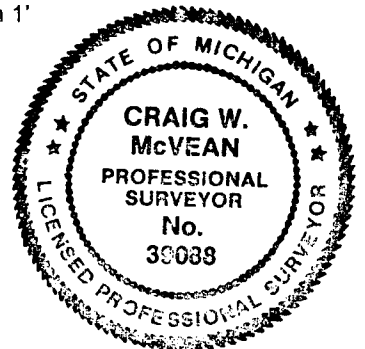

Signed by: Craig W. McVean
 Surveyor's Michigan License No.: 39088

Date: 12/7/2004