


STATE OF MICHIGAN
DEPARTMENT
OF
NATURAL RESOURCES

LAND CORNER RECORD

MISSAUKEE COUNTY
T 24 N R 5 W

DESCRIPTION OF CORNER NE corner, Section 8
CORNER MONUMENT Drove 1"x28" pipe in E. Top Road
DATE MONUMENT PLACED AND WITNESSED 10-27-71


WITNESSES TO CORNER.....	18" Oak	S 85 E	54.8'
	18" Oak	N 44 E	70.0'
	18" Oak	N 54 W	124.6'
	CTP. N-S 2 1/2" Top Rd	Dub W	8'
AND	Set Cor. Post w/location tag	S 45 W	66'

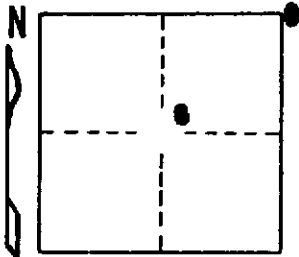

CIRCLE CORNER REGISTERED

DESCRIPTION IN DETAIL AS TO HOW CORNER WAS LOCATED AND IDENTIFIED OR RESTORED.

Corner set at intersection of N-S Highway County Road and E-W trail road, which fits a corner by proportion 1 mile W and 2 miles E very close.

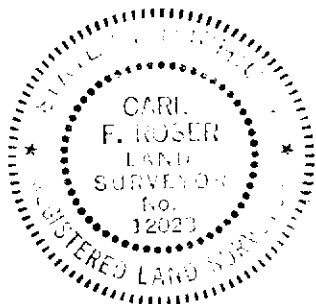

SURVEYOR'S SEAL

SIGNED Carl F. Roser 11-4-71 DATE
REGISTERED LAND SURVEYOR

DISTRIBUTION:

County Courthouse
Area Forester (Regions I & II)
District or Region Surveyor
Forestry Div., Lansing