


STATE OF MICHIGAN
DEPARTMENT
OF
NATURAL RESOURCES

LAND CORNER RECORD

MISSAUKEE COUNTY
T 8824N R 5 W

DESCRIPTION OF CORNER SE Corner, Section 6
CORNER MONUMENT Drive 1"x36" pipe in Blacktop Road
DATE MONUMENT PLACED AND WITNESSED 10-28-71
WITNESSES TO CORNER..... 22" E. Pine S 22 E 124.5'

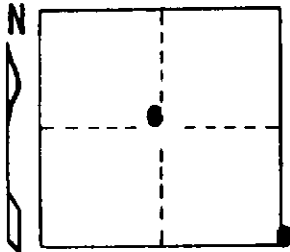


20" N. Pine N 88 W 67.8'
18" W. Pine S 74 W 121.1'
AND
Ctr. N-S D. Top Rd. Due W 2'

CIRCLE CORNER REGISTERED

DESCRIPTION IN DETAIL AS TO HOW CORNER WAS LOCATED AND IDENTIFIED OR RESTORED.

Corner set by proportion to U.S., on straight line, for 1 mile N & S. U.S. ran N three miles from Ctr. of Twp.

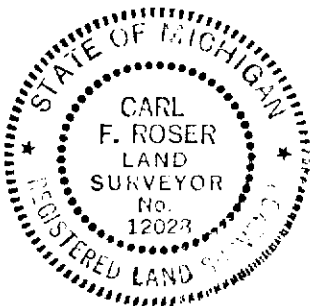

SURVEYOR'S SEAL

SIGNED Carl F. Roser DATE 11-4-71
REGISTERED LAND SURVEYOR 12023

DISTRIBUTION:

County Courthouse
Area Forester (Regions I & II)
District or Region Surveyor
Forestry Div., Lansing

R 4047
Rev. 10/68