


STATE OF MICHIGAN
DEPARTMENT
OF
NATURAL RESOURCES

LAND CORNER RECORD

MISSAUKEE COUNTY
T 24 N R 5 W

DESCRIPTION OF CORNER SE Corner, Section 7
 CORNER MONUMENT Found 1 1/2" pipe
 DATE MONUMENT PLACED AND WITNESSED 10-28-71
 WITNESSES TO CORNER..... 18" R. Pine N 48 W 112.0'

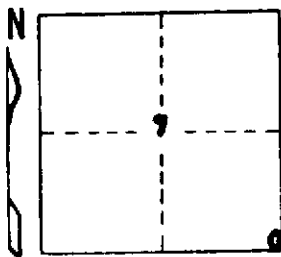


20" R. Pine N 79 W 112.6'
20" Oak N 75 E 158.6'
 AND
Ctr. E-W Trail Rd Due N 28'

CIRCLE CORNER REGISTERED

DESCRIPTION IN DETAIL AS TO HOW CORNER WAS LOCATED AND IDENTIFIED OR RESTORED.

Found 1 1/2" pipe. Corner on record at Missaukee County Road Comm.

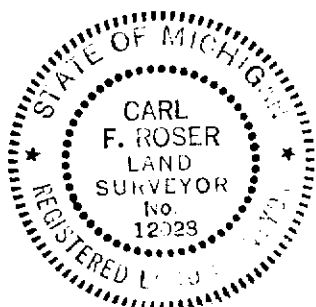

SURVEYOR'S SEAL

SIGNED Carl F. Roser DATE 11-4-71
 REGISTERED LAND SURVEYOR **12028**

DISTRIBUTION:

County Courthouse
 Area Forester (Regions I & II)
 District or Region Surveyor
 Forestry Div., Lansing

R 4047
 Rev. 10/68