


STATE OF MICHIGAN
DEPARTMENT
OF
NATURAL RESOURCES

LAND CORNER RECORD

T 24 N R 5 W

DESCRIPTION OF CORNER E 1/4 Corner, Section 7
CORNER MONUMENT Set 1"x36" pipe
DATE MONUMENT PLACED AND WITNESSED 10-28-71
WITNESSES TO CORNER..... 18" Maple S 65 W 84.0'

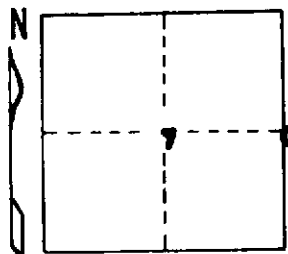


20" Maple N 82 W 152.7'
16" R. Pine S 85 E 165.0'
AND
Ctr. N-S B.Top Rd. Due W 9'

CIRCLE CORNER REGISTERED

DESCRIPTION IN DETAIL AS TO HOW CORNER WAS LOCATED AND IDENTIFIED OR RESTORED.

Corner set by proportion to U.S., on straight line for 1/2 miles N and 1/2 mile S.
U.S. ran N three miles from Ctr. of Twp.

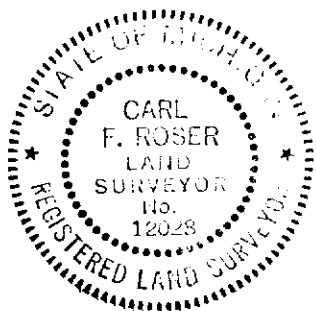

SURVEYOR'S SEAL

SIGNED

Carl F. Roser

DATE

11-4-71

DISTRIBUTION:

REGISTERED LAND SURVEYOR 12028

County Courthouse
Area Forester (Regions I & II)
District or Region Surveyor
Forestry Div., Lansing

R 4047
Rev. 10/68