


STATE OF MICHIGAN
DEPARTMENT
OF
NATURAL RESOURCES
LAND CORNER RECORD

MISSAUKEE COUNTY
T 24 N R 8 W

DESCRIPTION OF CORNER S 1/4 Cor. Sec. 7
CORNER MONUMENT Set 1"x36" pipe
DATE MONUMENT PLACED AND WITNESSED 10-12-71
WITNESSES TO CORNER.....

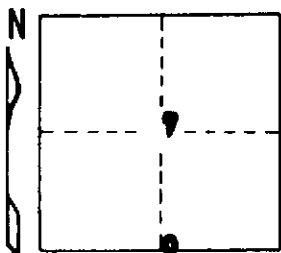


20" R. Pine S 46 E 61.8'
24" R. Pine S 88 W 108.0'
28" Oak N 11 W 188.5'
AND
Ctr. E-W B. Top Co. Rd. Due N 9.5'

CIRCLE CORNER REGISTERED

DESCRIPTION IN DETAIL AS TO HOW CORNER WAS LOCATED AND IDENTIFIED OR RESTORED.

Reestablished corner per Standard B.L.M. instructions.

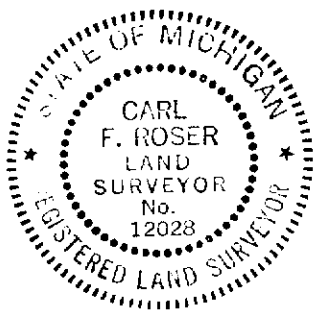

SURVEYOR'S SEAL

SIGNED Carl F. Roser DATE 10-19-71
REGISTERED LAND SURVEYOR 12028

DISTRIBUTION:

County Courthouse
Area Forester (Regions I & II)
District or Region Surveyor
Forestry Div., Lansing