


STATE OF MICHIGAN  
DEPARTMENT  
OF  
NATURAL RESOURCES

LAND CORNER RECORD

MISSAUKEE COUNTY  
T 24 N R 8 W


DESCRIPTION OF CORNER NE Cor. of Section 4  
CORNER MONUMENT Set DNR Mon by old stk bottom buried in N-S trail rd.  
DATE MONUMENT PLACED AND WITNESSED 10-12-71  
WITNESSES TO CORNER..... 23" R. Pine N 38 W 176.6'

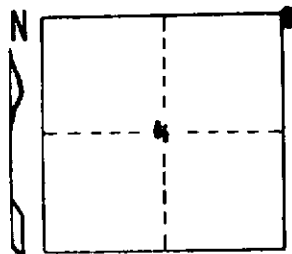

20" Oak S 87 W 140.9'  
20" W. Oak S 30 W 27.4'  
AND  
Gr. Trail Rd. East Due S 9'  
CIRCLE CORNER REGISTERED Rand. W. Due N. 14.3'

DESCRIPTION IN DETAIL AS TO HOW CORNER WAS LOCATED AND IDENTIFIED OR RESTORED.

Recovered old stake bottom from old Witness (7" W. Oak, S 30° W, 28') per 1915 survey by Marvill as noted in old field book at County Road Commission. Marvill's notes indicate one U.S.B.T. standing in 1915.

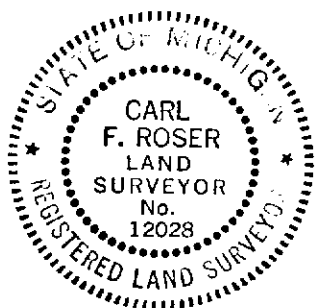

SURVEYOR'S SEAL

SIGNED Carl F. Roser DATE 10-19-71  
REGISTERED LAND SURVEYOR 12028

DISTRIBUTION:

County Courthouse  
Area Forester (Regions I & II)  
District or Region Surveyor  
Forestry Div., Lansing

R 4047  
Rev. 10/68