


STATE OF MICHIGAN
DEPARTMENT
OF
NATURAL RESOURCES

LAND CORNER RECORD

MISSAUKEE COUNTY
T 24 N R 8 W

DESCRIPTION OF CORNER E 1/4 corner, Section 6
CORNER MONUMENT Drove 1"x36" pipe in Blacktop road
DATE MONUMENT PLACED AND WITNESSED 10-28-71
WITNESSES TO CORNER..... 18" W. Pine S 33 W 154.3'

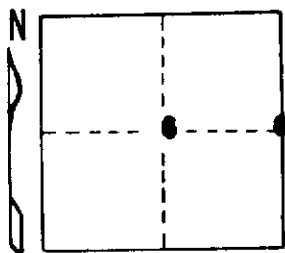


8" Cedar S 75 W 90.1'
10" Cedar N 68 W 63.7'
AND
Ctr. N-S Blacktop Rd Due W 2.5'

CIRCLE CORNER REGISTERED

DESCRIPTION IN DETAIL AS TO HOW CORNER WAS LOCATED AND IDENTIFIED OR RESTORED.

Corner set by proportion to U.S. on straight line, for 1/2 mile N. and 1-1/2 miles S.
U.S. ran N. three miles from center of Twp.

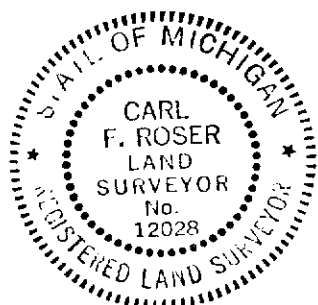

SURVEYOR'S SEAL

SIGNED

Carl F. Roser
REGISTERED LAND SURVEYOR 12028

DATE

11-4-71

DISTRIBUTION:

County Courthouse
Area Forester (Regions I & II)
District or Region Surveyor
Forestry Div., Lansing

R 4047
Rev. 10/68