LAND CORNER RECORDATION CERTIFICATE

Filing Requirement of Act 74, Mich. P.A. 1970

For corners in MISSAUKEE (County)

	Located In:	Corner Code #
1. Public Land Survey	T 24N R 5W	A-5, B-5,
	T ___ R ___	C-5
	T ___ R ___	
	T ___ R ___	
2. Property Controlling	S ___ T ___ R ___	
in Section	S ___ T ___ R ___	
3. Miscellaneous	S ___ T ___ R ___	
Property in Sec.	S ___ T ___ R ___	

Register of Deeds Stamp & File Number

4. Lot No. _____ , Recorded Plat _____
5. Private Claims _____

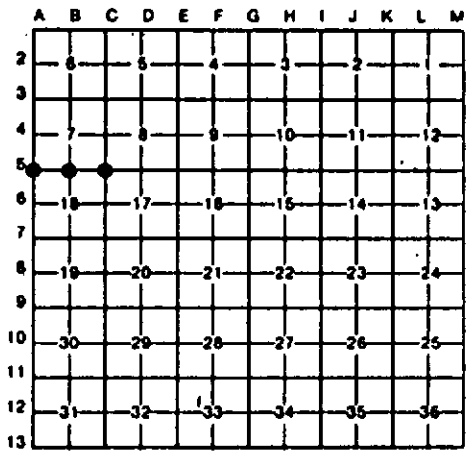

I, CARL F. ROSER, in a field survey on AUGUST 6, 19 92, do hereby certify that under requirements of P.A. 74, Michigan P.A. of 1970, the corner points mentioned in lines 1 and 2 above were in conformance with regulations and rules therefore as required in the current manual of survey instructions of the United States Department of the Interior, Bureau of Land Management or by a decree of a Court of Law and/or that the corner points mentioned in lines 3, 4 and 5 above were in conformance with the rules of the Michigan Board of Land Surveyors or by a Decree of a Court of Law; established, re-established, monumented, re-monumented, recovered, found as expressed below:

NOTE: Not more than 4 corners, all in the same town and range, may be recorded on this certificate.

A. Description of original monument and accessories and/or subsequent restoration:

A-5 B-5 C-5

(NO EVIDENCE OF G.L.O. CORNER, B.T'S, LINE TREES & TOPOGRAPHY, AS CALLED OUT IN THE G.L.O. LINE NOTES; UNLESS NOTED IN ITEM "B" BELOW.)

B. Description of corner evidence found and/or method applied in restoring or reestablishing corner:

A-5
FD DNR MON FOR NW COR S-18. THIS COR FD (1/2" PIPE AS RECOVERED & WIT BY LS, G.E. YOUNG IN 1966) & MONUMENTED IN 1971 DEPT SURVEY OF SECTIONS TO NORTH. COR FALLS IN SAND TRAIL RD INTERSEC (RDS N & W) & IN LINE W/CTR B.TOP RD S & E.

B-5
FD 1" PIPE FOR N 1/4 COR SEC 18. COR SET IN 1971 DEPT SURVEY (ON LINE BETWEEN NE & NW SEC CORS AND PROPORTIONATE MEAS TO U.S. DIST.). COR IS 3 1/2' SOUTH OF CTR OF E-W B.TOP ROAD. FD NEWER 1/2" REROD SOUTH 29.7'.

C-5
FD 1 1/2" PIPE FOR NE COR SEC 18. PIPE FOUND & ACCEPTED IN 1971 DEPT SURVEY OF SEC 7. (COR WAS ON RECORD AT MISS. CO RD COMM.) CTR E-W TRAIL IS 26' NORTH.

C. Description of monument for corner and accessories established to perpetuate locating the position of the corner:

A-5
FD DNR MON.
#23" R PINE N70°W 135.1'
#22" OAK N40°E 63.2'
#16" TW MAPLE N65°E 29.41'
#15" MAPLE S65°E 73.66'
#35" OAK S 5°E 68.99'
SET CED POST W/ LOC TAG N45°E 47'
#=WIT BY OTHERS. ‡=RLS G.YOUNG (1966) & C.ROSER (1971) WITS.

B-5
FD 1" GALV PIPE.
#32" R OAK N11°W 138.1'
28" R PINE N40°E 64.2'
#26" R PINE S58°W 107.9'
SET CED POST W/ LOG TAG SOUTH 33'
‡RLS C. ROSER 1971 WIT.

C-5
FD 1 1/2" PIPE, ADDED CED POST W/LOC TAG.
24" R PINE N82°W 124.5'
#22" R PINE N84°W 112.6'
#23" R PINE N50°W 111.8'
2" R PINE N70°E 6.8'
3" R PINE S60°W 3.9'
‡RLS C. ROSER 1971 WIT.

STATE OF MICHIGAN
CARL F. ROSER
LAND SURVEYOR
No. 12028
REGISTERED LAND SURVEYOR

Signed by Carl F. Roser 12028 4-28-94 Date _____

Surveyor's Michigan License No. _____

FORM APPROVED BY MICHIGAN STATE BOARD OF LAND SURVEYORS, JAN. 28, 1971
REVISED MAY 14, 1975
REVISED JAN., 1983