

**LAND CORNER RECORDATION CERTIFICATE**  
**Filing Requirement of Act 74, Mich. P.A. 1970**

For corners in  
MISSAUKEE  
(County)

Located In: \_\_\_\_\_ Corner Code ~~##~~

- |                                       |                             |                  |
|---------------------------------------|-----------------------------|------------------|
| 1. Public Land Survey                 | T <u>24N</u> R <u>5W</u>    | <u>A-6, A-7,</u> |
|                                       | T _____ R _____             | <u>B-7</u>       |
|                                       | T _____ R _____             | _____            |
|                                       | T _____ R _____             | _____            |
| 2. Property Controlling<br>in Section | S <u>19</u> T _____ R _____ | <u>2</u>         |
|                                       | S _____ T _____ R _____     | _____            |
| 3. Miscellaneous<br>Property in Sec.  | S _____ T _____ R _____     | _____            |
|                                       | S _____ T _____ R _____     | _____            |

Register of Deeds Stamp & File Number

4. Lot No. \_\_\_\_\_, Recorded Plat \_\_\_\_\_  
 5. Private Claims \_\_\_\_\_

A	B	C	D	E	F	G	H	I	J	K	L	M
2	6	5	4	3	2	1						
3												
4	7	8	9	10	11	12						
5												
6	18	17	16	15	14	13						
7	•	•										
8	19	20	21	22	23	24						
9												
10	30	29	28	27	26	25						
11												
12	31	32	33	34	35	36						
13												

I, CARL F. ROSER, in a field survey on AUGUST 6, 19 92, do hereby certify that under requirements of P.A. 74, Michigan P.A. of 1970, the corner points mentioned in lines 1 and 2 above were in conformance with regulations and rules therefore as required in the current manual of survey instructions of the United States Department of the Interior, Bureau of Land Management or by a decree of a Court of Law and/or that the corner points mentioned in lines 3, 4 and 5 above were in conformance with the rules of the Michigan Board of Land Surveyors or by a Decree of a Court of Law; established, re-established, monumented, re-monumented, recovered, found as expressed below:

**NOTE:** Not more than 4 corners, all in the same town and range, may be recorded on this certificate.

**A. Description of original monument and accessories and/or subsequent restoration:**

<p>A-6                  (NO EVIDENCE OF G.L.O. CORNER, B.T.'S, LINE TREES &amp; TOPOGRAPHY, AS CALLED OUT IN THE G.L.O. LINE NOTES; UNLESS NOTED IN ITEM "B" BELOW.)                  (B. CONT.) THE LOCATION OF E-W 1/4 LINE. G. YOUNG REPLACED R.R. SPIKE WITH "T" IRON. L.S. N. PARKER USED THIS COR. IN CERT OF SUR FOR PART OF FRL NW 1/4 OF SEC 18, LT S-1, PG 197, RECORDED DEC. 26, 1974.</p>	<p>A-7                  FD IRON W/L.S. CAP #14102, J. WILCOX, AT INTERSEC OF B.TOP RDS N-S-W &amp; IN LINE W/FENCE EAST FOR SW COR S-18. GEORGE E. YOUNG, LS #10710 FOUND 1-1/2" PIPE HERE IN 1966 SURVEY OF S-13. (RD HAS LIFT ON IT IN THIS AREA.)</p>	<p>B-7                  REESTABLISHED S 1/4 CORNER SEC 18; 1/2" SOUTH OF INTERSEC OF OLD FN REMAINS E-W-S (LANDOWNER BUILT NEWER E-W FENCE IN REMAINS OF OLD E-W FENCE).</p>
---	--	--

**B. Description of corner evidence found and/or method applied in restoring or reestablishing corner:**


<p>A-6                  FD IR (BATTERED L.S., J. WILCOX CAP) IN N-S B.TOP RD (2' E OF C/L) FOR W 1/4 COR S-18. L.S., G. YOUNG FD RR SPIKE HERE IN 1966 SUR FOR S-13. HE FD SPIKE IN LINE W/SEC COR'S N &amp; S &amp; IN LINE W/ FN'S E &amp; W. YOUNG STATES "1/4 LINE FN BASED ON SURVEY APPROX 40 YRS AGO BY WILLIAM CANTNELL JR". HE ACCEPTED FN AS BEST AVAILABLE EVIDENCE AS TO (CONT. ABOVE)</p>	<p>A-7                  FD IR 1.5' DEEP W/RLS CAP, RAISED RLS CAP TO SURFACE WITH 1/2" X 16" REROD. POWER POLE N60°W 58.64' 118" R PINE N30°W 66.93' RR TIE COR FN POST EAST 33' RR TIE COR FN POST S45°W 48.31' 1=L.S. G.E. YOUNG 1966 MIT.</p>	<p>B-7                  SET DNR MON. 3" R PINE N60°W 12.18' 3" R PINE N80°E 11.70' 33" SUG MAPL S70°E 47.39' 8" MAPL (CLP10) S70°W 28.18'</p>	<p>2                  ESTABLISHED NE COR OF NW 1/4 OF NE 1/4 OF S-19 PER STANDARD BLM INSTRUCTIONS. APPROX COR OF OLD MOVEN WIRE FN REMAINS TO N &amp; W IS 9' ± SOUTH AND 14' ± EAST. W'LY EDGE OF SWAMP IS 250' ± 25' WEST.</p>
--	--	---	---

**C. Description of monument for corner and accessories established to perpetuate locating the position of the corner:**

<p>A-6                  FD IRON W/RLS CAP #14102. 115° HENLOCK N70°W 55.91' 110° W PINE EAST 46.78' 111° W PINE S35°E 57.27' 135° W PINE S60°W 69.50' FD CONC MON WEST 33'</p>	<p>A-7                  FD IR 1.5' DEEP W/RLS CAP, RAISED RLS CAP TO SURFACE WITH 1/2" X 16" REROD. POWER POLE N60°W 58.64' 118" R PINE N30°W 66.93' RR TIE COR FN POST EAST 33' RR TIE COR FN POST S45°W 48.31' 1=L.S. G.E. YOUNG 1966 MIT.</p>	<p>B-7                  SET DNR MON. 3" R PINE N60°W 12.18' 3" R PINE N80°E 11.70' 33" SUG MAPL S70°E 47.39' 8" MAPL (CLP10) S70°W 28.18'</p>	<p>2                  DROVE 1" X 48" GALV PIPE W/RLS CAP. SET CED POST. 6" MAPLE N35°W 28.4' 10" CEDAR N80°E 27.8' 7" MAPLE S 5°E 23.7' 8" CEDAR S50°W 55.7'</p>
--	--	---	--

WRLS G. YOUNG WIT.  
 WIT BY OTHERS.

Signed by Carl F. Roser 4-28-94  
 Surveyor's Michigan License No. 12028

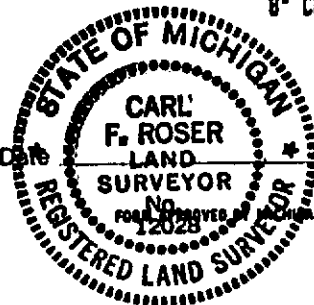

MICHIGAN STATE BOARD OF LAND SURVEYORS, JAN. 28, 1971  
 REVISED MAY 14, 1975  
 REVISED JAN., 1963