


STATE OF MICHIGAN  
DEPARTMENT  
OF  
NATURAL RESOURCES

## LAND CORNER RECORD

MISSAUKEE COUNTY  
T 24 N R 6 W


DESCRIPTION OF CORNER SW corner Sec. 7  
 CORNER MONUMENT Found DNR Monument  
 DATE MONUMENT PLACED AND WITNESSED 8-10-71  
 WITNESSES TO CORNER..... 12" Elm S 66 W 15.0'

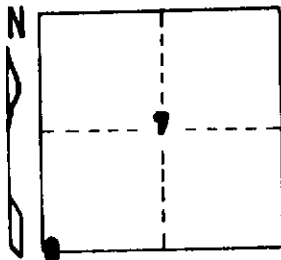

9" Twin Maple N 28 E 15.2'  
18" Maple N 85 E 42.5'  
 AND Ctr. E-W Fire Lane Due N 35'  
Ctr. Fire Lane North Due E 18'  
Random E Due S 7'

DESCRIPTION IN DETAIL AS TO HOW CORNER WAS LOCATED AND IDENTIFIED OR RESTORED.

**Previous Dept. Survey of record.**

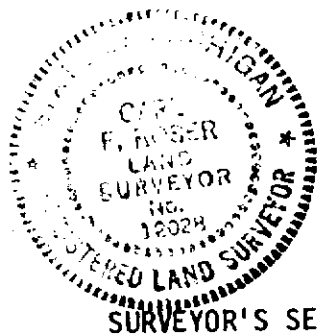

SURVEYOR'S SEAL

SIGNED Carl F. Rose DATE 8-17-71  
 REGISTERED LAND SURVEYOR 12028

DISTRIBUTION:

County Courthouse  
 Area Forester (Regions I & II)  
 District or Region Surveyor  
 Forestry Div., Lansing

R 4047  
 Rev. 10/68