

STATE OF MICHIGAN  
DEPARTMENT  
OF  
NATURAL RESOURCES

LAND CORNER RECORD


MISSAUKEE COUNTY  
T 24 N R 6 W

DESCRIPTION OF CORNER NW Corner, Section 7

CORNER MONUMENT Found DNR Mon. along side of 1 1/2" pipe

DATE MONUMENT PLACED AND WITNESSED 8-10-71

WITNESSES TO CORNER..... 20" Beach S 42 E 8.7'

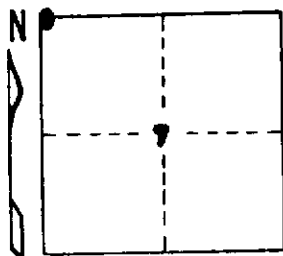

20" Beach N 67 W 15.2'


20" Beach N 10 E 24.4'

AND Ctr N-S Trail Rd Due E 28'  
Ctr Trail Rd. East Due N 30'

CIRCLE CORNER REGISTERED

DESCRIPTION IN DETAIL AS TO HOW CORNER WAS LOCATED AND IDENTIFIED OR RESTORED.

**Dept. Monument of previous record.**

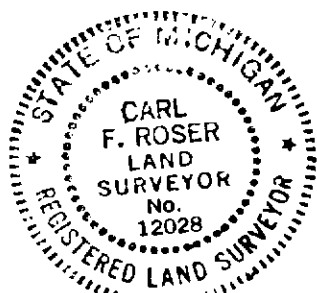

SURVEYOR'S SEAL

SIGNED

*Carl F. Roser*

REGISTERED LAND SURVEYOR

DATE

8-17-71

DISTRIBUTION:

12028

County Courthouse  
Area Forester (Regions I & II)  
District or Region Surveyor  
Forestry Div., Lansing

R 4047  
Rev. 10/68