

STATE OF MICHIGAN  
DEPARTMENT  
OF  
NATURAL RESOURCES

LAND CORNER RECORD


MISSAUKEE COUNTY  
T 26 N R 6 W

DESCRIPTION OF CORNER N 1/4 corner on E line Section 8

CORNER MONUMENT Set 1"x36" pipe

DATE MONUMENT PLACED AND WITNESSED 8-19-71

WITNESSES TO CORNER..... 9" Cedar N 83 E 66.2'

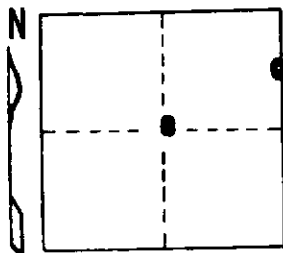

8" Cedar S 56 E 78.6'


4" Wild Apple S 74 W 27.9'

AND  
Ctr. N-S Dirt Road Due E 1'

CIRCLE CORNER REGISTERED

DESCRIPTION IN DETAIL AS TO HOW CORNER WAS LOCATED AND IDENTIFIED OR RESTORED.

Corner established equidistant and on line between Section corner N and 1/4 corner S, which is in line with old fence remains to West.

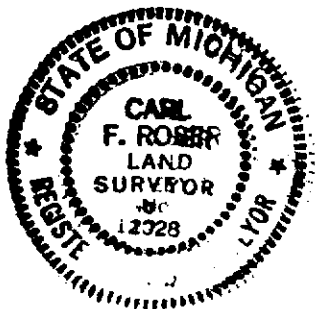

SURVEYOR'S SEAL

SIGNED Carl F. Roer DATE 8-20-71  
REGISTERED LAND SURVEYOR

DISTRIBUTION:

12028

County Courthouse  
Area Forester (Regions I & II)  
District or Region Surveyor  
Forestry Div., Lansing

R 4047  
Rev. 10/68