


STATE OF MICHIGAN  
DEPARTMENT  
OF  
NATURAL RESOURCES  
LAND CORNER RECORD

MISSAUKIE COUNTY  
T 24 N R 6 W

DESCRIPTION OF CORNER Ctr. NW 1/4 Sec. 8  
CORNER MONUMENT Set 1"x26" pipe, Cedar Guard Post w/loc. tag.  
DATE MONUMENT PLACED AND WITNESSED 9-22-71  
WITNESSES TO CORNER..... 7" Elm N 15 W 17.4'

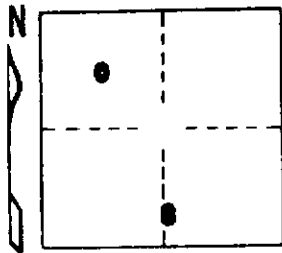


9" Elm, cluster of 4 S 73 W 28.5'  
10" Elm N 76 E 71.7'  
AND

CIRCLE CORNER REGISTERED

DESCRIPTION IN DETAIL AS TO HOW CORNER WAS LOCATED AND IDENTIFIED OR RESTORED.

Corner established per standard BM instructions. Old fences in vicinity of this corner are way wild.

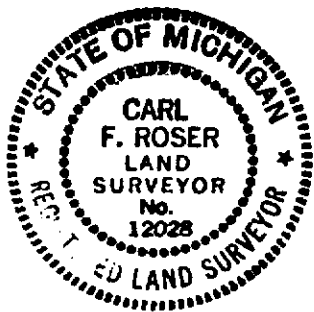

SURVEYOR'S SEAL

*Carl F. Roser*  
SIGNED

REGISTERED LAND SURVEYOR

DATE 9-29-71

**12028**

DISTRIBUTION:

County Courthouse  
Area Forester (Regions I & II)  
District or Region Surveyor  
Forestry Div., Lansing

R 4047  
Rev. 10/68