


STATE OF MICHIGAN
DEPARTMENT
OF
NATURAL RESOURCES

LAND CORNER RECORD

MISSAUKEE COUNTY
T 24 N R 6 W

DESCRIPTION OF CORNER S 1/4 corner, Section 8
CORNER MONUMENT Set DNR Monument
DATE MONUMENT PLACED AND WITNESSED 8-12-71
WITNESSES TO CORNER..... 10" Maple S 20 E 18.1'

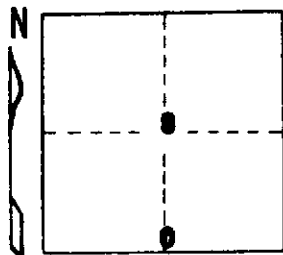


8" Maple S 47 W 32.4'
6" Red Pine N 40 E 54.0'
AND
In Ctr E-W Dirt Rd Due N 2'

CIRCLE CORNER REGISTERED

DESCRIPTION IN DETAIL AS TO HOW CORNER WAS LOCATED AND IDENTIFIED OR RESTORED.

Corner reestablished 33' South of corner fence post (Fn. E,W,N). Fn. N at 1/4 mile West fits split of 1/2 mile West.

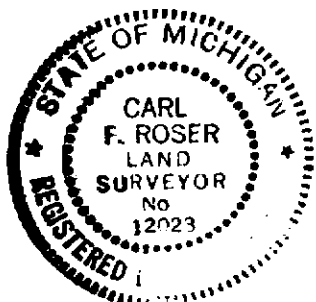

SURVEYOR'S SEAL

SIGNED Carl F. Roser DATE 8-18-71
REGISTERED LAND SURVEYOR

18028

DISTRIBUTION:

County Courthouse
Area Forester (Regions I & II)
District or Region Surveyor
Forestry Div., Lansing

R 4047
Rev. 10/68