


STATE OF MICHIGAN  
DEPARTMENT  
OF  
NATURAL RESOURCES

LAND CORNER RECORD

MISSAUKEE COUNTY  
T 24 N R 6 W

DESCRIPTION OF CORNER NE corner, Section 8  
CORNER MONUMENT Set DNR Monument & Guard post  
DATE MONUMENT PLACED AND WITNESSED 8-18-71  
WITNESSES TO CORNER.....

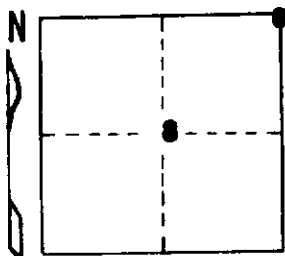


32" B. Cherry	N 7 E	35.2'
18" B. Cherry	S 76 E	81.2'
12" triple B. Cherry	S 26 W	79'
AND Ctr. N-S Dirt Rd	Due W	9'

CIRCLE CORNER REGISTERED

DESCRIPTION IN DETAIL AS TO HOW CORNER WAS LOCATED AND IDENTIFIED OR RESTORED.

Corner established on average line of old Twp Rd grade and average split of ROW fences for one mile South, at double the distance of South 1/2 mile (1/2 mile), which fits the East end of old fence West at the North 1/16 corner between Secs. 8 & 9.

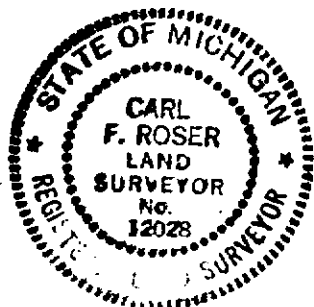

SURVEYOR'S SEAL

SIGNED Carl F. Roser DATE 8-20-71  
REGISTERED LAND SURVEYOR 12028

DISTRIBUTION:

County Courthouse  
Area Forester (Regions I & II)  
District or Region Surveyor  
Forestry Div., Lansing

R 4047  
Rev. 10/68