


STATE OF MICHIGAN  
DEPARTMENT  
OF  
NATURAL RESOURCES

LAND CORNER RECORD

WISBAUXEE COUNTY  
T 24 N R 6 W

DESCRIPTION OF CORNER N 1/4 corner, Section 6  
CORNER MONUMENT Set DNR Monument (see falls in ctr of N-S dirt Rd.)  
DATE MONUMENT PLACED AND WITNESSED 12-16-71  
WITNESSES TO CORNER..... 5" Cherry S 69 E 58.2'

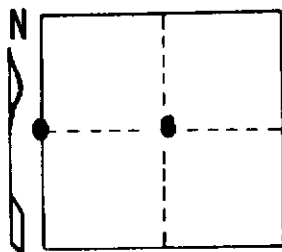


9" Cherry N 84 E 49.8'  
8" Maple N 45 W 83.7'  
AND

CIRCLE CORNER REGISTERED

DESCRIPTION IN DETAIL AS TO HOW CORNER WAS LOCATED AND IDENTIFIED OR RESTORED.

**Reestablished corner per Std. B.L.M. instructions.**

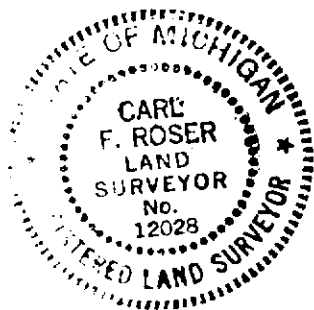

SURVEYOR'S SEAL

SIGNED Carl F. Roser DATE 12-28-71  
REGISTERED LAND SURVEYOR 12028

DISTRIBUTION:

County Courthouse  
Area Forester (Regions I & II)  
District or Region Surveyor  
Forestry Div., Lansing

R 4047  
Rev. 10/68