

STATE OF MICHIGAN
DEPARTMENT
OF
NATURAL RESOURCES

LAND CORNER RECORD


MISSAUKEE COUNTY
T 24 N R 6 W

DESCRIPTION OF CORNER N 1/4 corner, Section 7

CORNER MONUMENT Found 1 1/2" pipe

DATE MONUMENT PLACED AND WITNESSED 8-10-71

WITNESSES TO CORNER..... 8" Maple S 82 E 16.8'

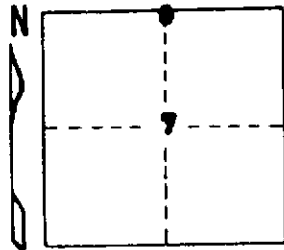

5" Maple S 80 W 20.6'


4" Maple N 6 W 14.5'

AND Ctr. E-W Trail Rd Due N 30'

CIRCLE CORNER REGISTERED

DESCRIPTION IN DETAIL AS TO HOW CORNER WAS LOCATED AND IDENTIFIED OR RESTORED.

Recovered 1 1/2" pipe as set by FRED C. MIRZEL to perpetuate stake which was found or established by Wm. Cantwell (deceased surveyor - not registered) many years ago. Cantwell went around Sections 6 & 7 according to Mirzel (In his 80s).

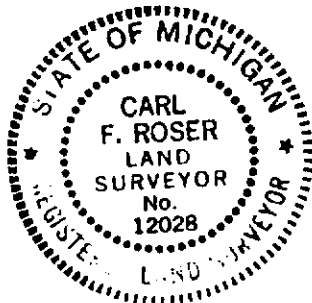

SURVEYOR'S SEAL

SIGNED Carl F. Roser DATE 8-17-71
REGISTERED LAND SURVEYOR

12028

DISTRIBUTION:

County Courthouse
Area Forester (Regions I & II)
District or Region Surveyor
Forestry Div., Lansing

R 4047
Rev. 10/68