


STATE OF MICHIGAN
DEPARTMENT
OF
NATURAL RESOURCES

LAND CORNER RECORD

MISSAUKEE COUNTY
T 24 N R 6 W

DESCRIPTION OF CORNER E 1/16 on N. Line of Sec. 7
CORNER MONUMENT Set 1"x36" pipe
DATE MONUMENT PLACED AND WITNESSED 8-12-71
WITNESSES TO CORNER..... 6" Maple S 42 W 31.1'

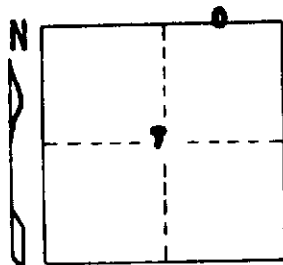


9" Maple S 54 E 39.4'
8" Maple N 72 E 33.1'
AND
Ctr E-W Trail Road Due N 36'

CIRCLE CORNER REGISTERED

DESCRIPTION IN DETAIL AS TO HOW CORNER WAS LOCATED AND IDENTIFIED OR RESTORED.

Corner established by Standard BLM directions.

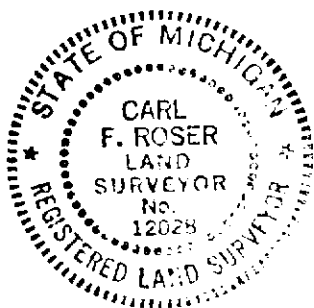

SURVEYOR'S SEAL

SIGNED Carl F. Roser DATE 8-19-71
REGISTERED LAND SURVEYOR
12028

DISTRIBUTION:

County Courthouse
Area Forester (Regions I & II)
District or Region Surveyor
Forestry Div., Lansing

R 4047
Rev. 10/68